


T.6S.,R.1W.,W.M.

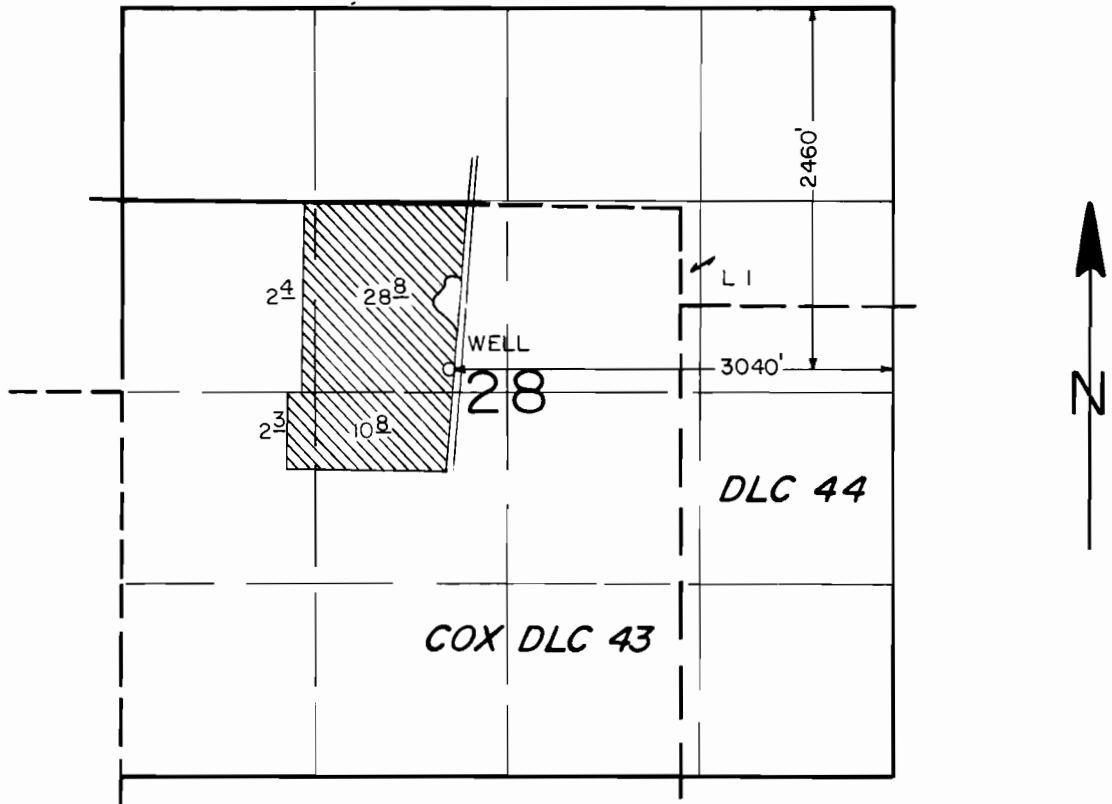

SCALE: 1" = 1320'

FINAL PROOF SURVEY UNDER

Application No. G-10827 Permit No. G-9932
IN NAME OF

HARVEY E. MIKKELSON

Surveyed APRIL 8 1986, by T.M. WARREN