90684

T. 6S., R. 2W., W.M.

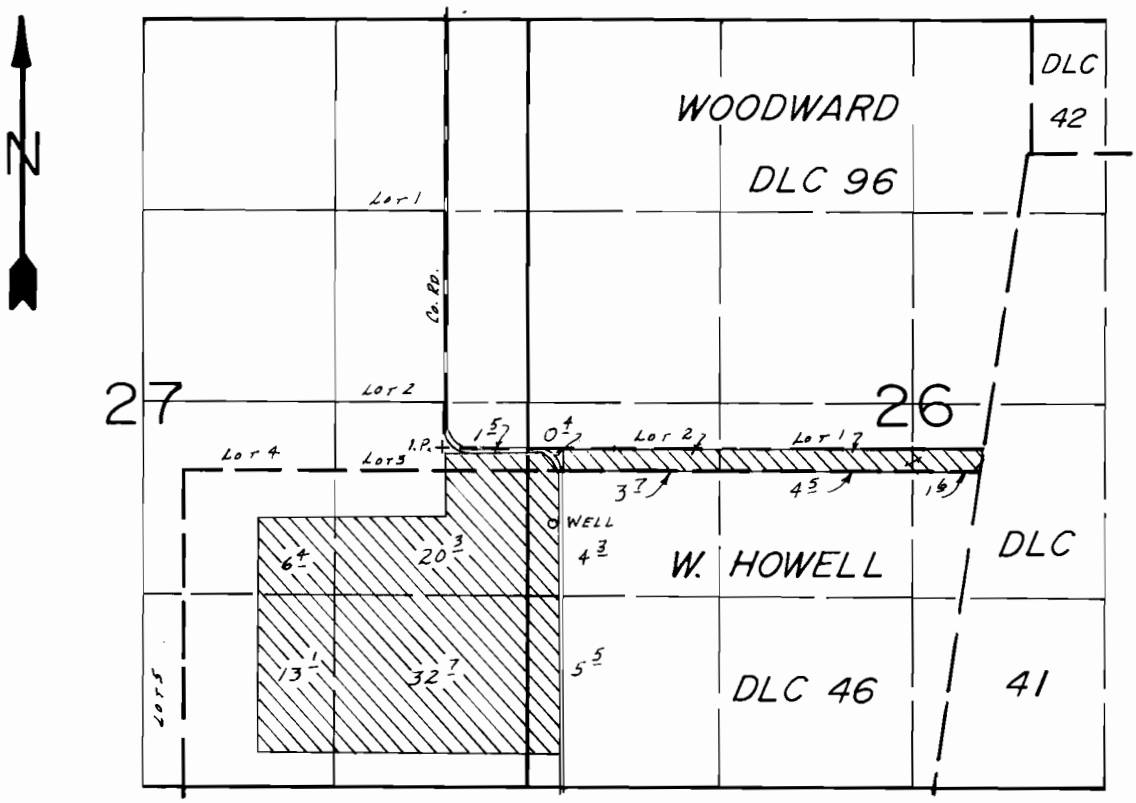

WELL LOC.: 510'S. & 750'E. FROM SW COR. WOODWARD DLC 96.

SCALE: 1" = 1320'

FINAL PROOF SURVEY

UNDER

Application No. G-10828 Permit No. G-9933

IN NAME OF

CARL F. JENSEN

Surveyed Apr. 1 19 86, by T.M. WARREN

DFN-6LL-204
DFN-1P-72

4/22/86
BWB