


T. 38 & 4 S., R. 1 W., W.M.

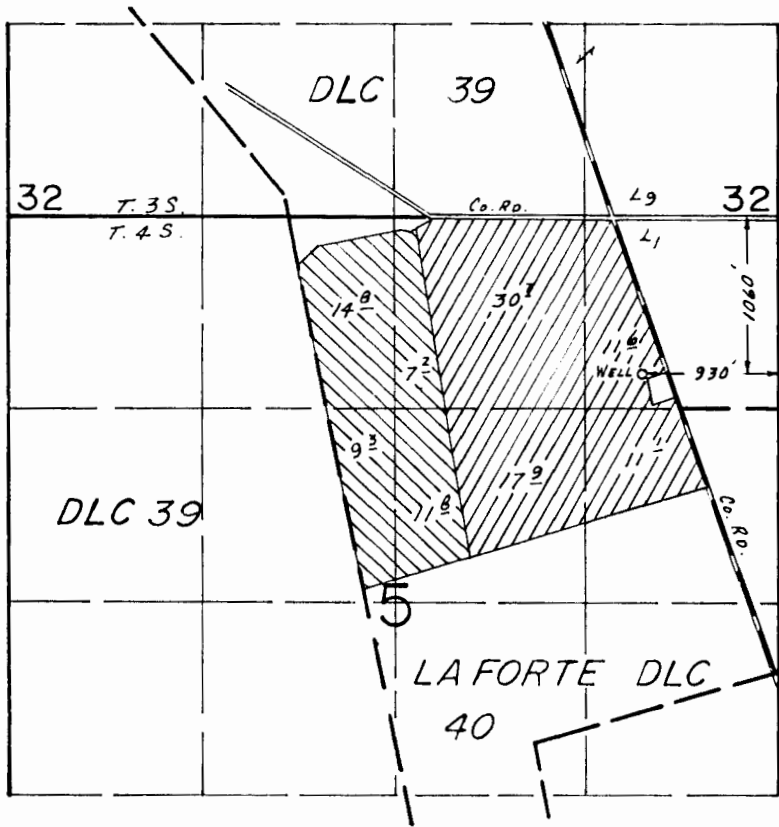

 PRIMARY
 SUPPLEMENTAL

SCALE: 1"=1320'

FINAL PROOF SURVEY
UNDER

Application No. G-10954 Permit No. G-10299...
IN NAME OF

.....RICHARD A. HAENER.....

Surveyed Mar. 19... 19.86, by T. M. WARREN.....