


T. 7S., R. 2W., W.M.

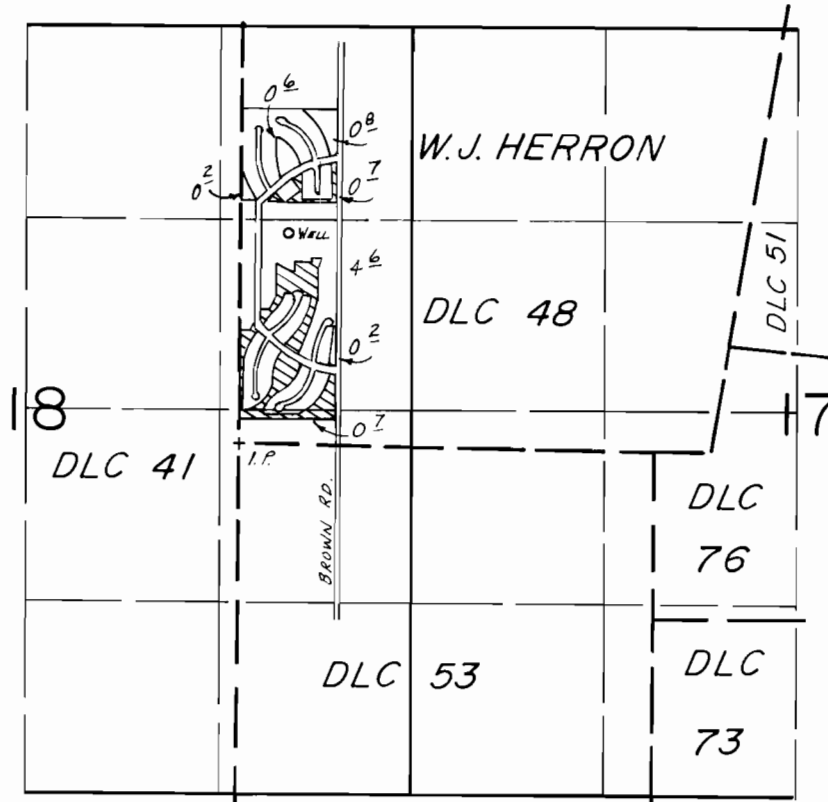

WELL LOC.: 72' S. & 46.7' E. FROM NW COR. SE⁴NE⁴, SEC. 18.

SCALE: 1" = 1320'

FINAL PROOF SURVEY
UNDER

Application No. G:11238.. Permit No. G:10353...
IN NAME OF

SURFWOOD VILLA HOMEOWNERS ASSOCIATION

Surveyed Apr. 18, 1986, by T.M. WARREN.....

5/1/86
BWB

41047-278-42A