


T.5S., R.1W., W.M.

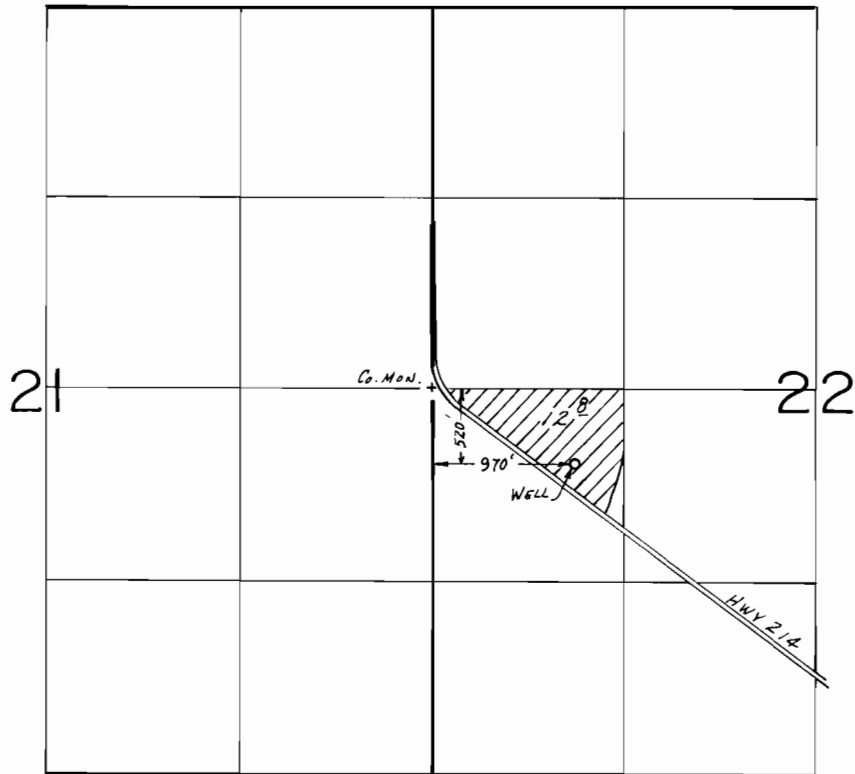

SCALE: 1" = 1320'

**FINAL PROOF SURVEY**  
UNDER

Application No. G:11276 Permit No. G:10401....  
IN NAME OF

.....BERNHARD R. HITZ.....

Surveyed Mar. 28. 19.86, by I.M. WARREN.....

4/14/86  
R.W.S.

41047-228-126B