


T. 6S., R. 2W., W.M.

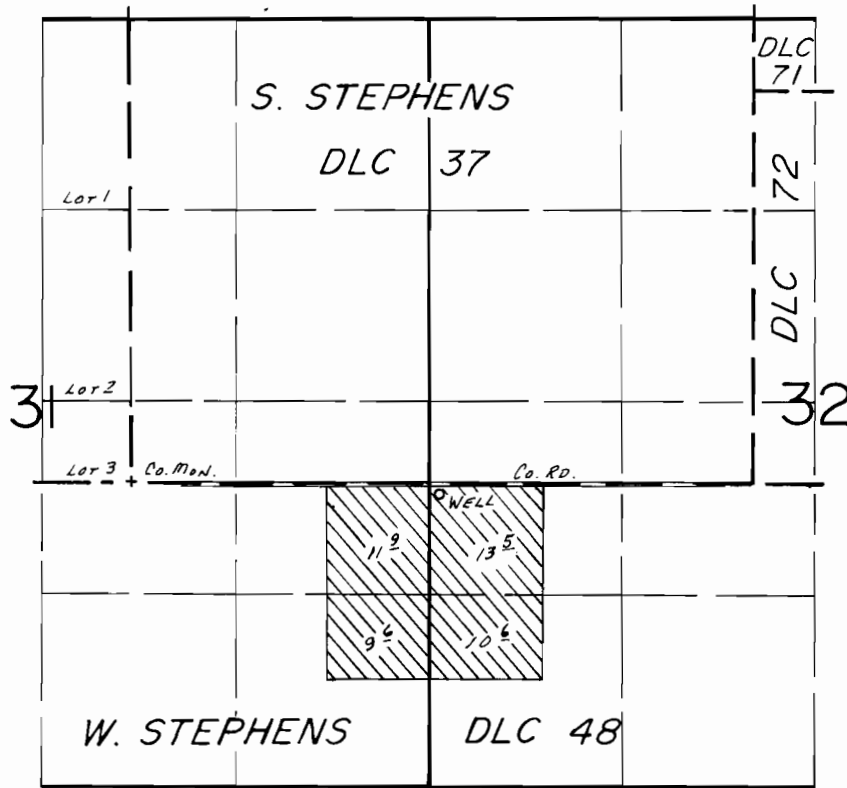

WELL LOC.: 60'S. & 2110' E. FROM SW COR. S. STEPHENS DLC 37

SCALE: 1" = 1320'

FINAL PROOF SURVEY UNDER

Application No. G-11365. Permit No. G-10486...
IN NAME OF

DELPHINE K. & CLETUS L. WOODS

Surveyed Apr. 2, 1986, by T.M. WARREN...

4/22/86
BWB