90684

T.5S., R.2W., W.M.

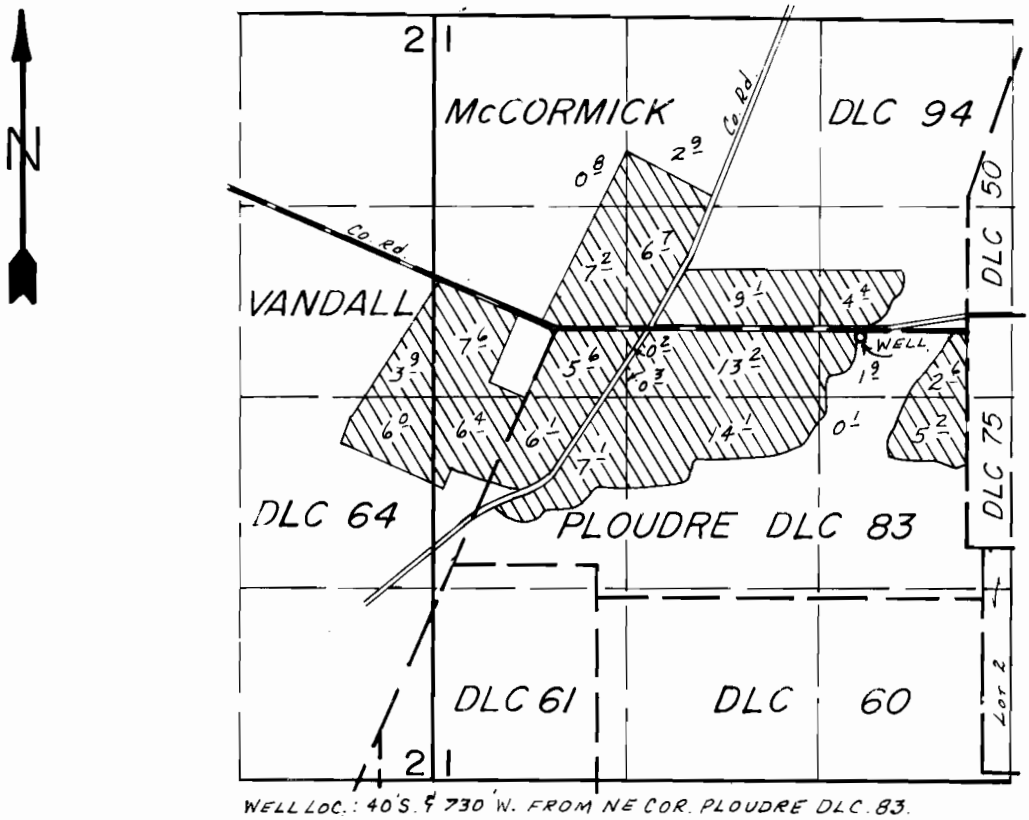

SCALE: 1" = 1320'

FINAL PROOF SURVEY

UNDER

Application No. G-11455 **Permit No.** G-10564

IN NAME OF

EDGAR W. CROSBY

Surveyed Apr. 4 **19**86, **by** T.M. WARREN

4/17/86
RWB

DFN-6LL-193