


T.7S.,R.3W., W.M.

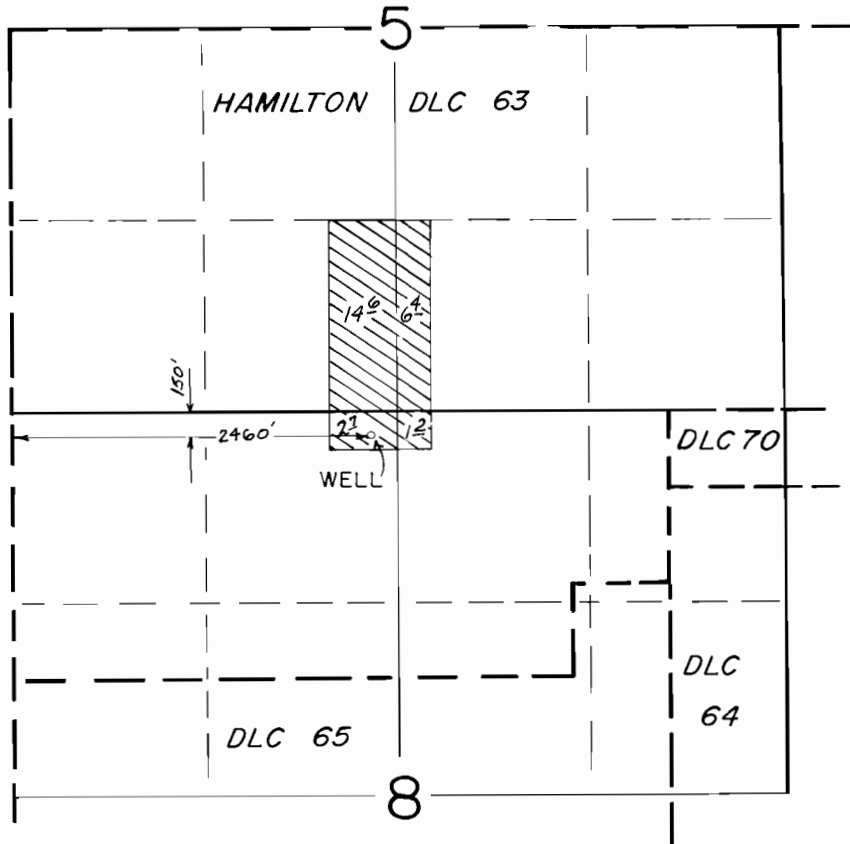

SCALE: 1" = 1320'

FINAL PROOF SURVEY
UNDER

Application No. G-9912 Permit No. G-8929
IN NAME OF

VIRGIL L. PADE

Surveyed AUG. 1 1985, by B.W. BISHOP