


T.2S., R.2W., W.M.

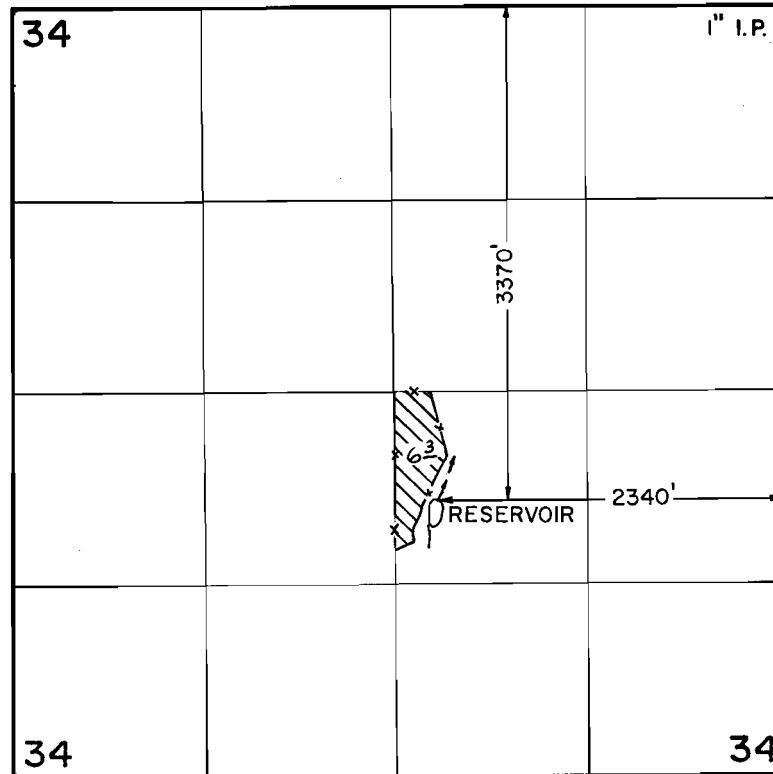

SCALE 1" = 1320'

FINAL PROOF SURVEY
UNDER

57147 43079
Application No. R-57146 Permit No. R-7344
IN NAME OF

WILLIAM J. MCGOWAN

Surveyed JULY 31, 1985, by T.M. WARREN