


# T. 2 S., R. 2 W., W.M.

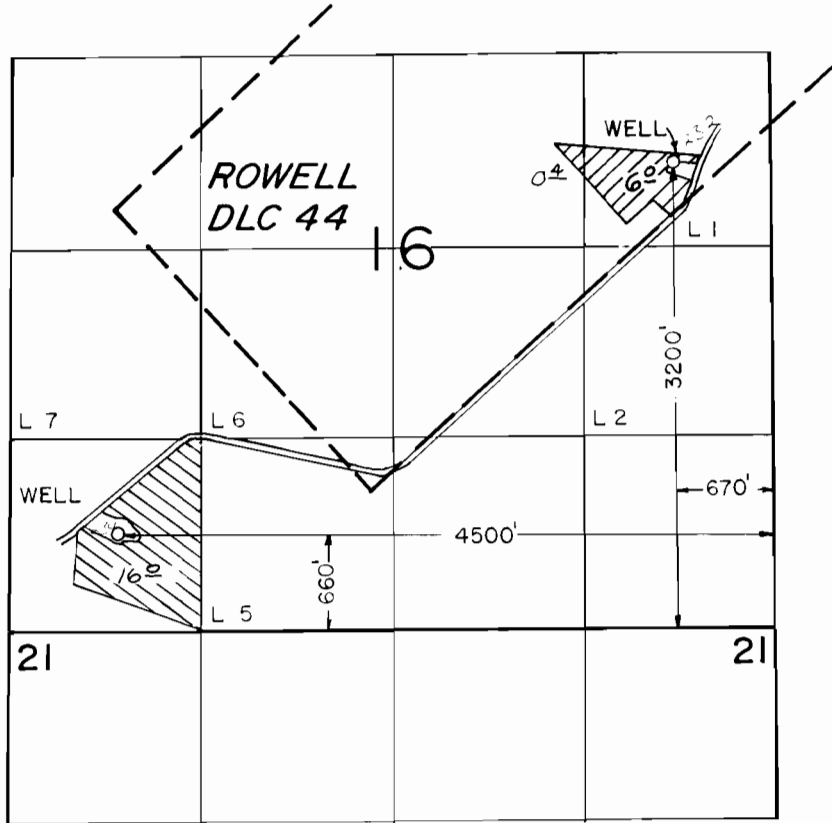

## FINAL PROOF SURVEY

UNDER

SCALE 1" = 1320'

Application No. G-8160 Permit No. G-7519  
 G-8158 Permit No. G-7518

IN NAME OF  
**TIM D. DAVIS**

Surveyed JULY 29 19 85, by T. M. WARREN