


T. 5 S., R. 1 E., W. M.

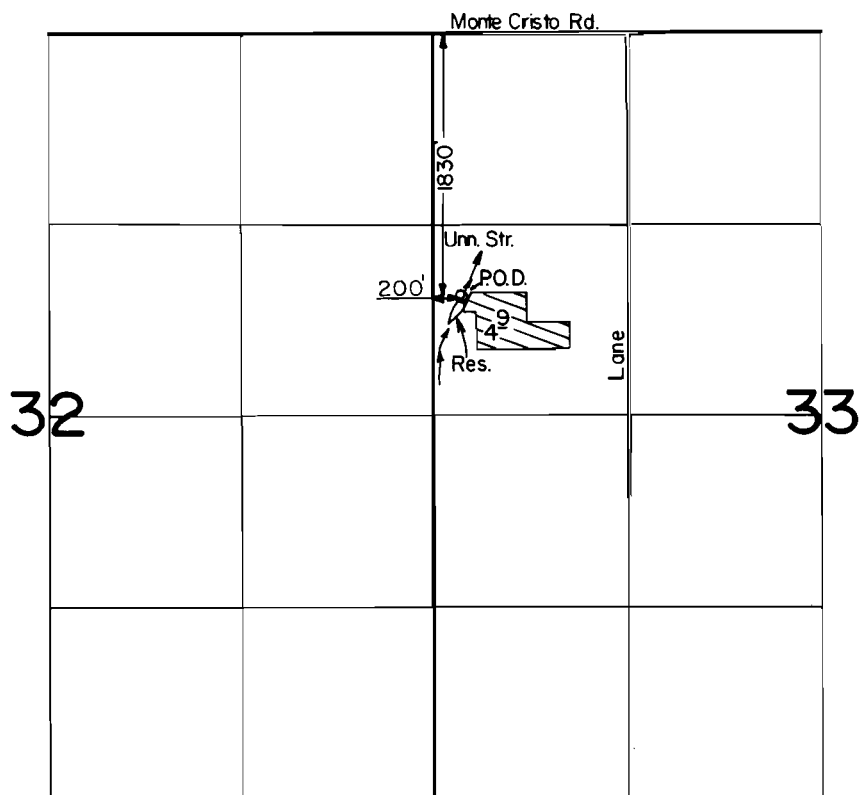

Scale: 1" = 1320'

FINAL PROOF SURVEY

UNDER

R-61061 R-8273
Application No. 61706.... Permit No. 45789.....
IN NAME OF

ILIYA REUTOV

Surveyed JULY 18, 1985, by T. Warren.....