


T.5S., R.1E., W.M.

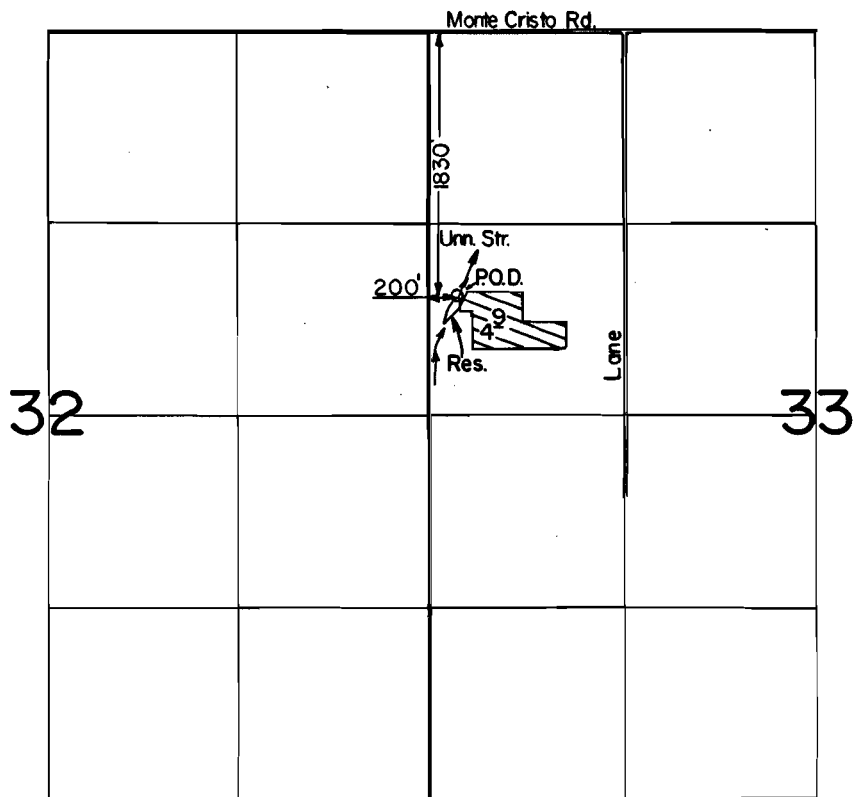

Scale: 1" = 1320'

FINAL PROOF SURVEY
UNDER

R-61061 R-8273
Application No. 61706.... Permit No. 45789.....

IN NAME OF

ILIYA REUTOV

Surveyed JULY 18, 1985, by T. Warren.....