


T. 26S., R. 4W., W.M.

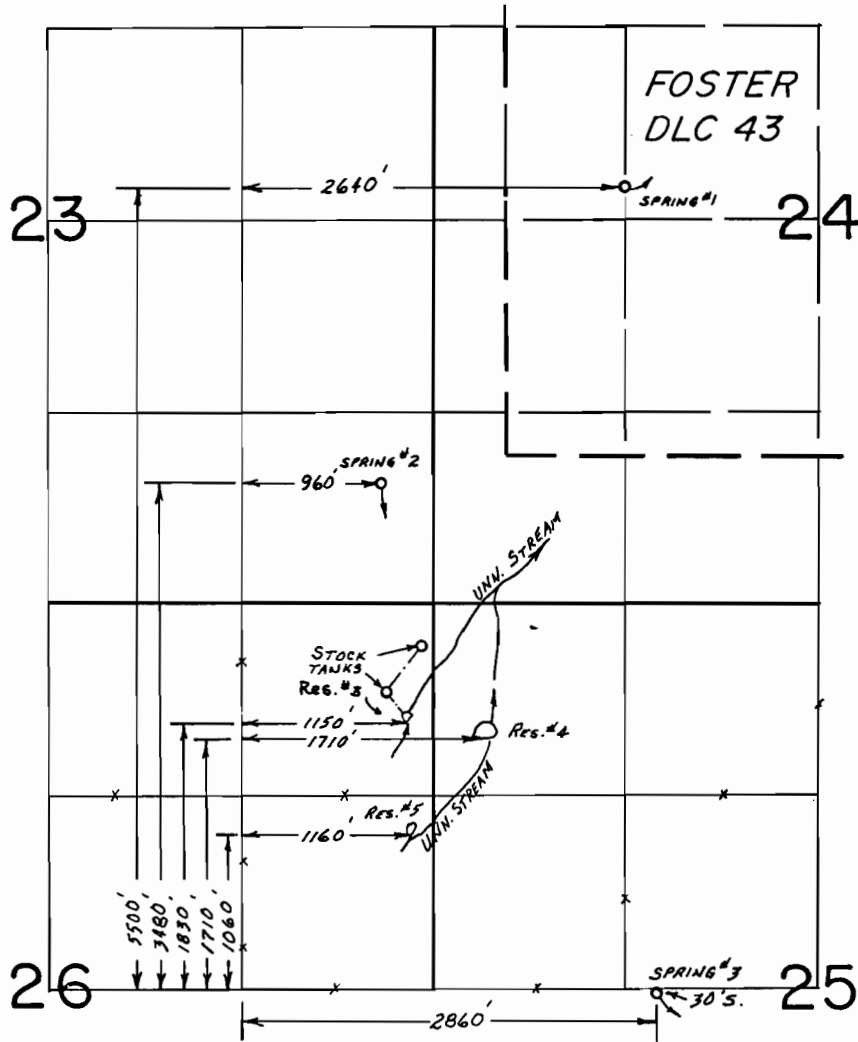

**FINAL PROOF SURVEY**  
UNDER

R-43573                      R-5004  
Application No. 43574... Permit No. 32585.....  
IN NAME OF

.....WILLIAM & LINDA CALHOUN.....

Surveyed AUG. 30... 1974., by L. H. NUNN.....  
APR. 16 1980                      J. S. DONALDSON