


# T. 26S., R. 4W., W.M.

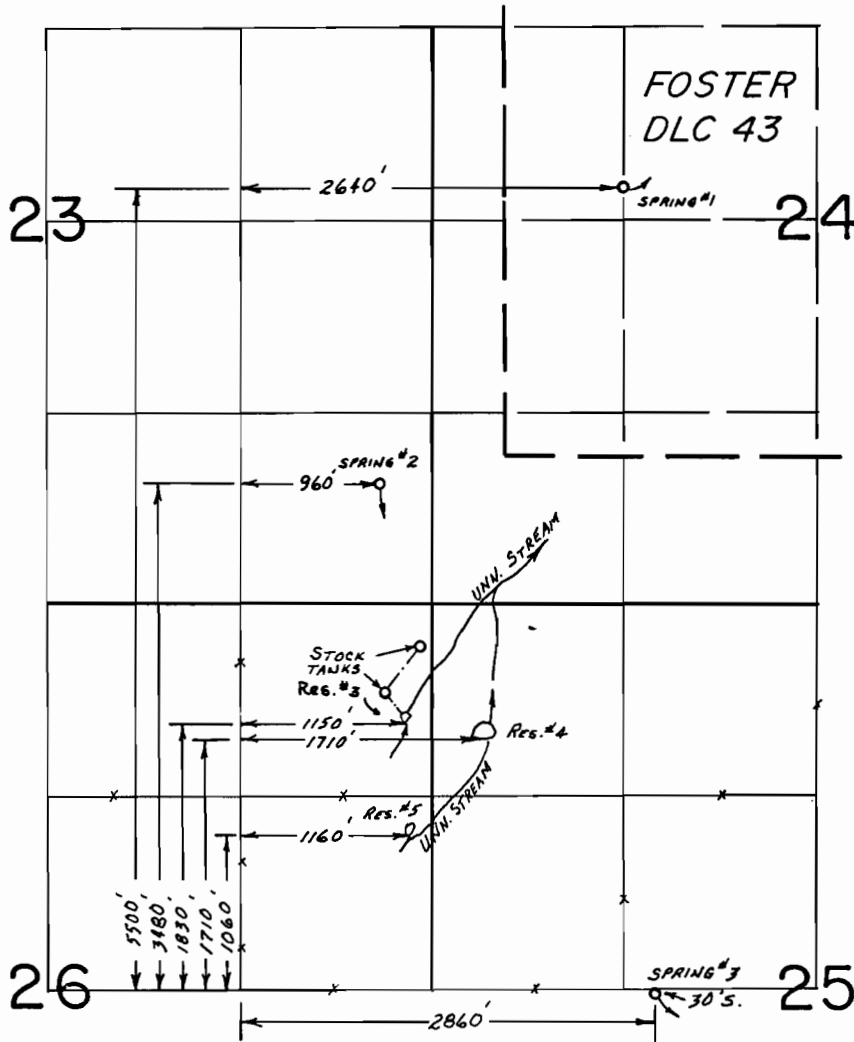

## FINAL PROOF SURVEY UNDER

R-43573                      R-5004  
 Application No. 43574... Permit No. 32585.....  
 IN NAME OF

.....WILLIAM & LINDA CALHOUN.....

Surveyed AUG. 30... 1974., by L.H. NUNN.....  
 APR. 16 1980                      J.S. DONALDSON