


T.25S. R.5W. W.M.

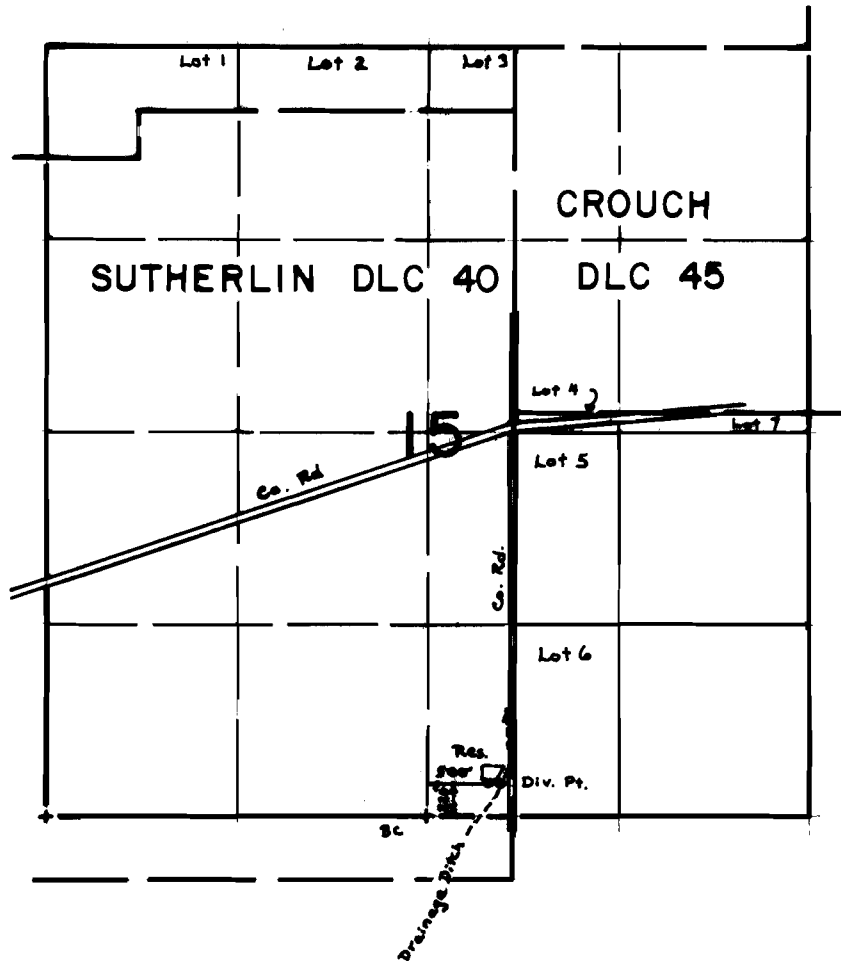

SCALE: 4" = 1 mile

FINAL PROOF SURVEY
UNDER

Application No. R-56768 Permit No. R-7405
IN NAME OF

.....Ralph W. and Anne Patterson.....

Surveyed Feb. 21, 1979, by S. Donaldson...