


T. 29S., R. 4W., W.M.

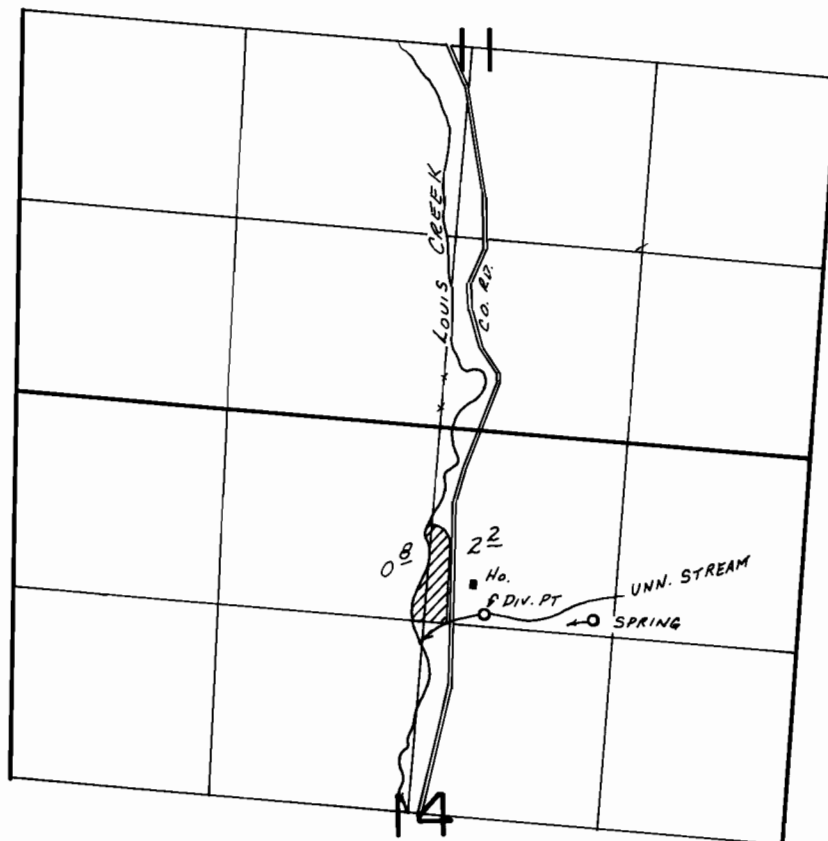

DIV. PTS. LOC.: UNN. STREAM - 1270'S. & 290'E.; SPRING - 1320'S. & 1020'E., BOTH FROM N. 1/4 COR. SEC. 14.

FINAL PROOF SURVEY UNDER

Application No. 51090.. Permit No. 38547.....
IN NAME OF

.....Rita Y. Pearson.....

Surveyed JUNE 23, 1960, by J.S. DONALDSON