


T.23S. R.5W. W.M.

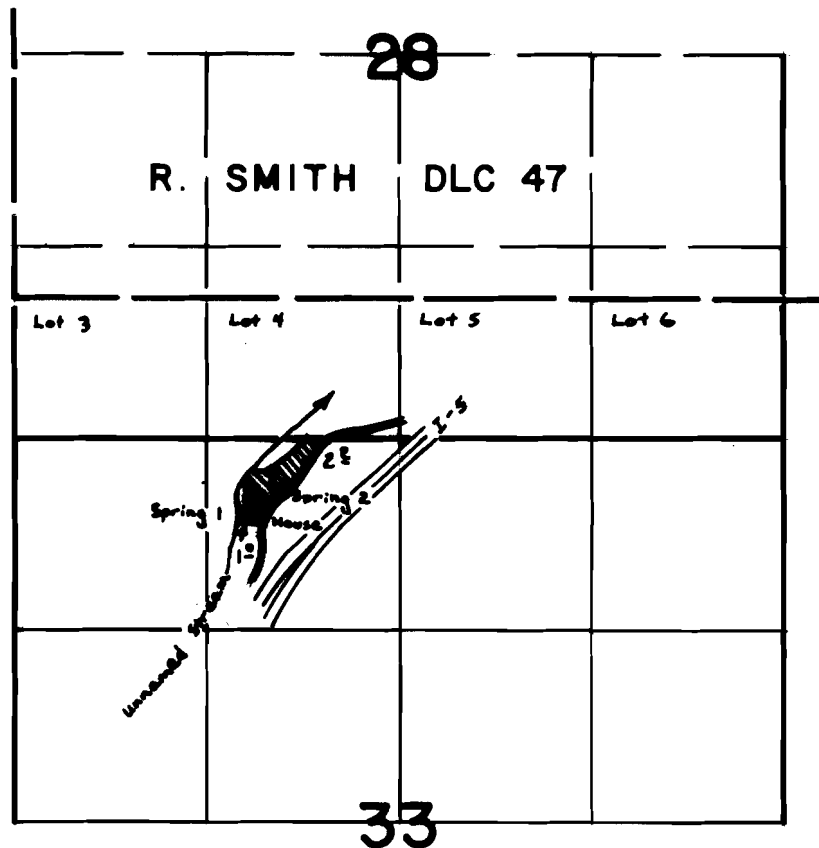

Springs Located: 1- 500's & 1050' W; 2- 350's & 850' W; both from the NW cor of, Sec 33

SCALE: 4" = 1 mile

FINAL PROOF SURVEY UNDER

Application No. 54265 Permit No. 40718
IN NAME OF

ROBERT W. & TOMI R. MARTIN

Surveyed Oct. 2, 1979, by S. Donaldson.