


T.30S. R.1&2W. W.M.

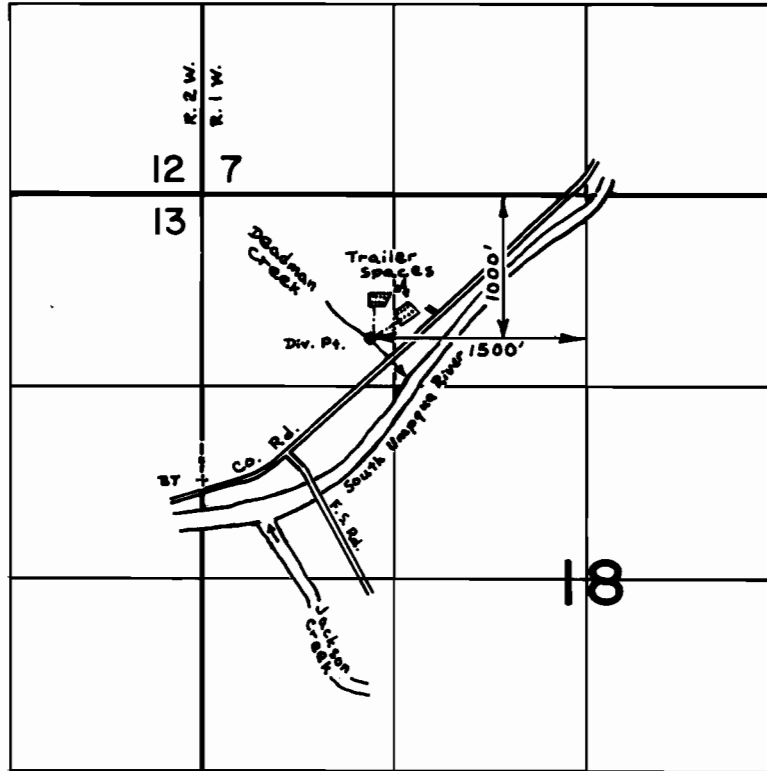

SCALE: 4" = 1 mile

**FINAL PROOF SURVEY  
UNDER**

Application No. 54887 Permit No. 41165  
IN NAME OF

TILLER PARK ASSOCIATES

Surveyed March 28, 1979., by S. Donaldson...