


T. 26S., R. 3W., W.M.  
SEC. 34

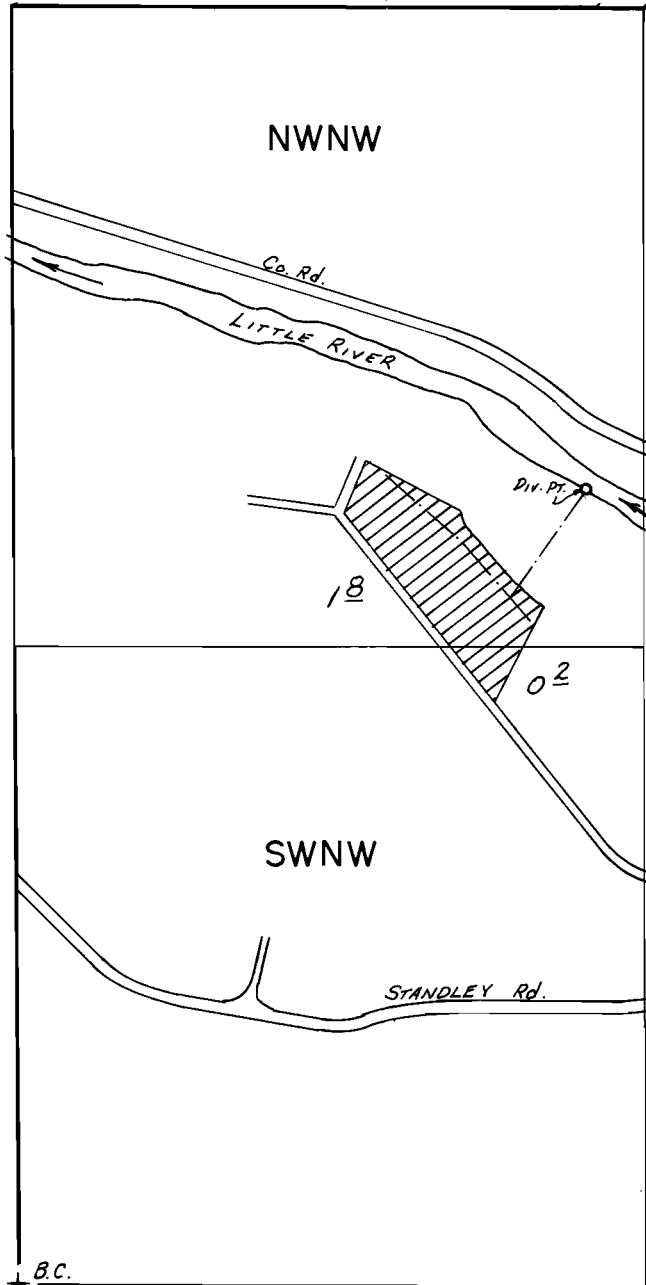

Div. Pt. Loc.: 1650' N. & 1180' E. FROM W. 1/4 COR. SEC. 34

SCALE: 1" = 400'

**FINAL PROOF SURVEY**

UNDER

Application No. 54995... Permit No. 41210.....  
IN NAME OF

.....DORWIN LEWIS KELLER.....

Surveyed APR. 29. 19.80, by J.S. DONALDSON