


T. 29S., R. 4W., W.M.

SEC. 20

SEC. 21

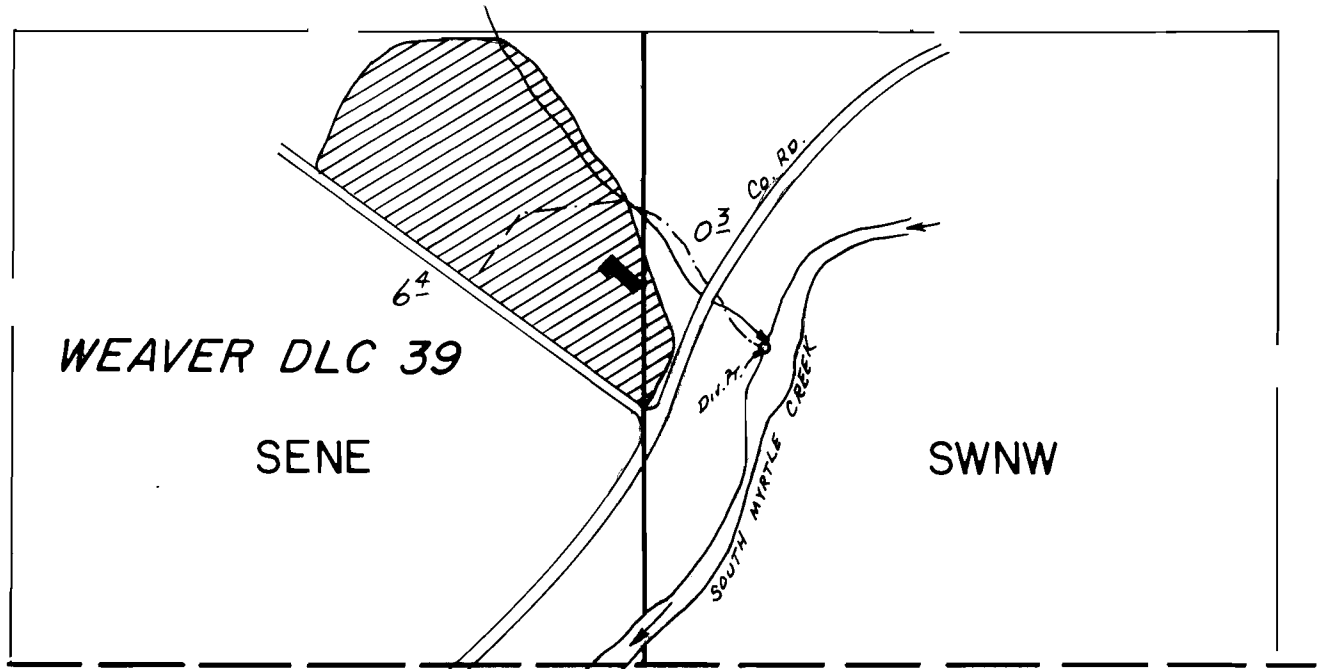

D.I.P. Loc.: 665 N. 255 E. FROM W. $1/4$ COR. SEC. 21.

SCALE: $1'' = 400'$

FINAL PROOF SURVEY
UNDER

Application No. 56970. Permit No. 42897.....
IN NAME OF

.....JAMES M. SEATON.....

Surveyed JUNE 12, 1980, by J.S. DONALDSON