


T. 28S., R. 6W., W.M.
SEC. 3

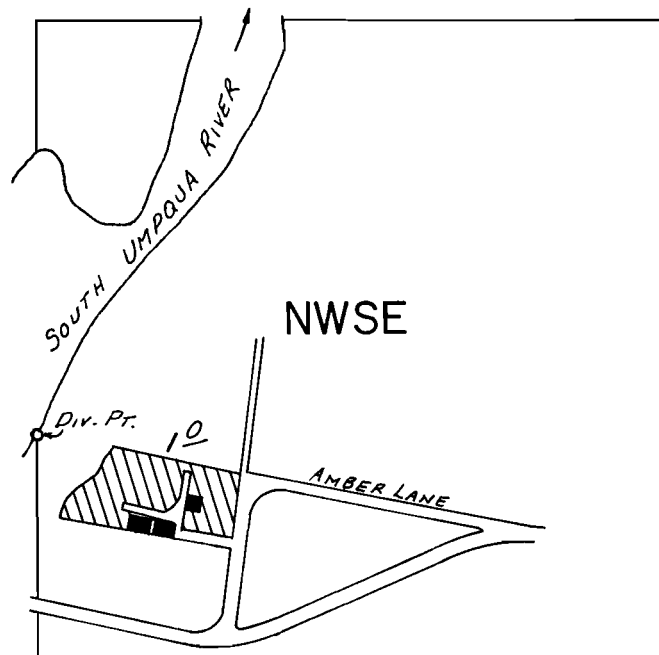

Div. Pt. Loc.: 460' N. FROM SW COR. NW 1/4 SE 1/4 SEC. 3

SCALE: 1" = 400'

FINAL PROOF SURVEY
UNDER

Application No. 57092... Permit No. 43015.....
IN NAME OF

.....ELBERT L. WORKS.....

Surveyed APR. 1..... 1980., by J.S. DONALDSON