


T.2N., R.10E., W.M.
SECTION 21

1/4 COR.

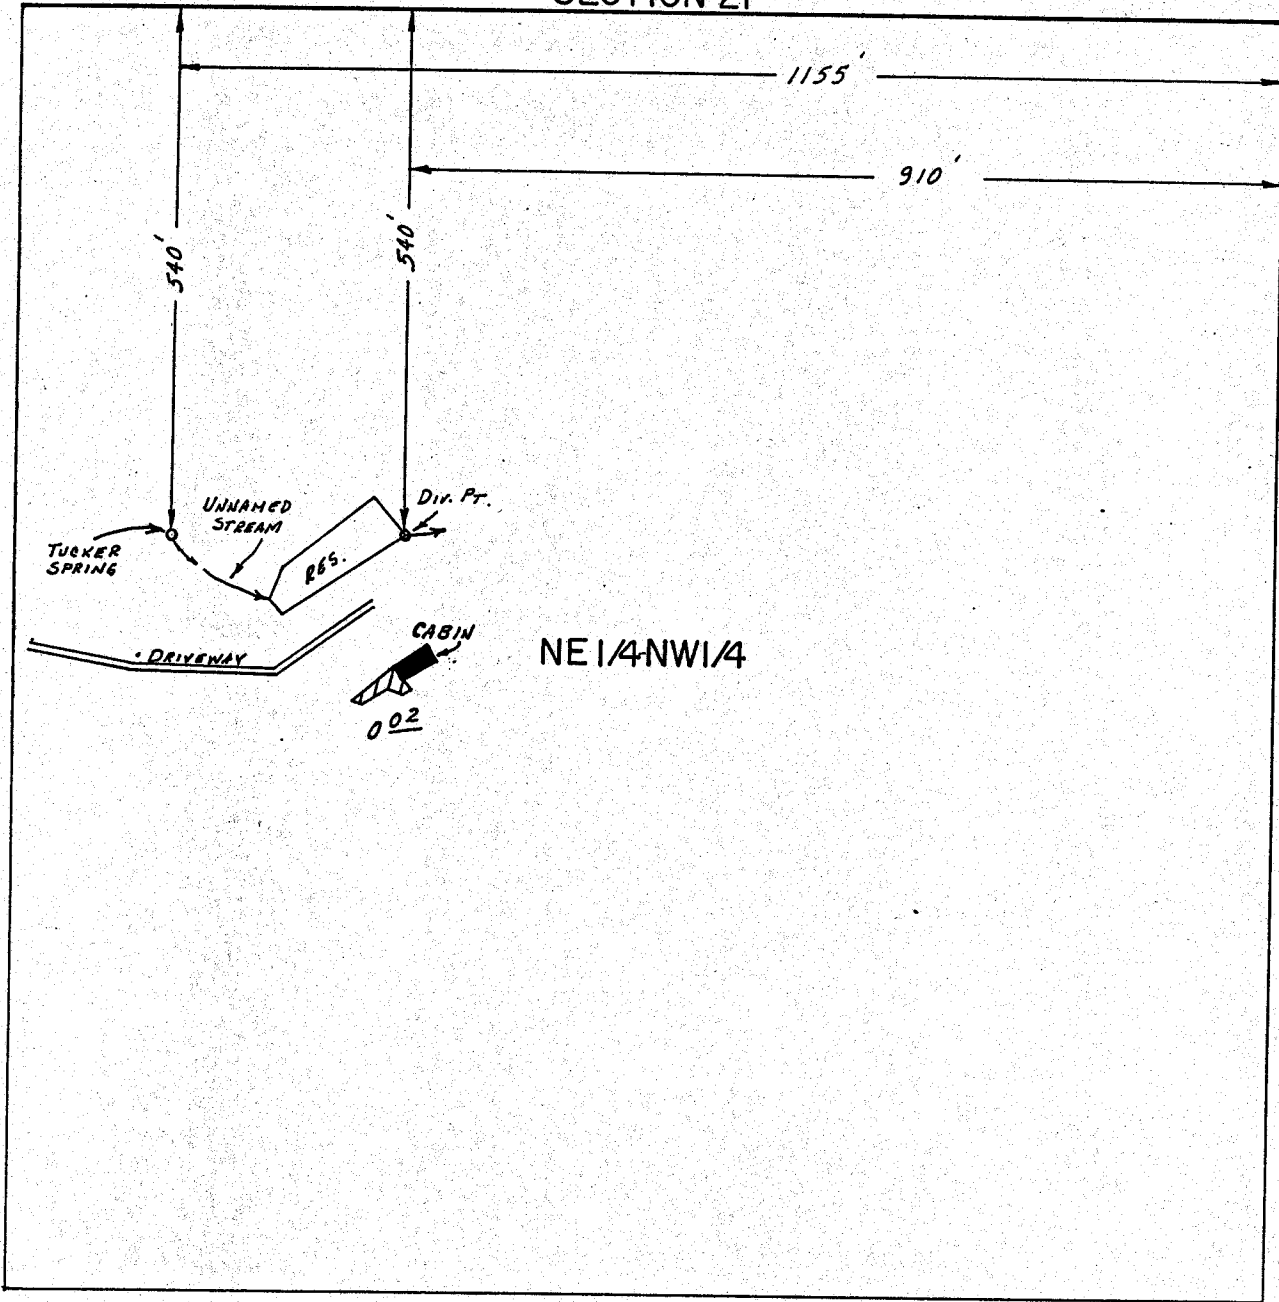

SCALE: 1" = 200'

FINAL PROOF SURVEY
UNDER

R-67896 R-10034
Application No. 67698 Permit No. 48954
IN NAME OF

IOLA B. HICKOCK

Surveyed Aug. 27, 1985, by T.M. WARREN.....