


T. 39S., R. 3W., W. M.

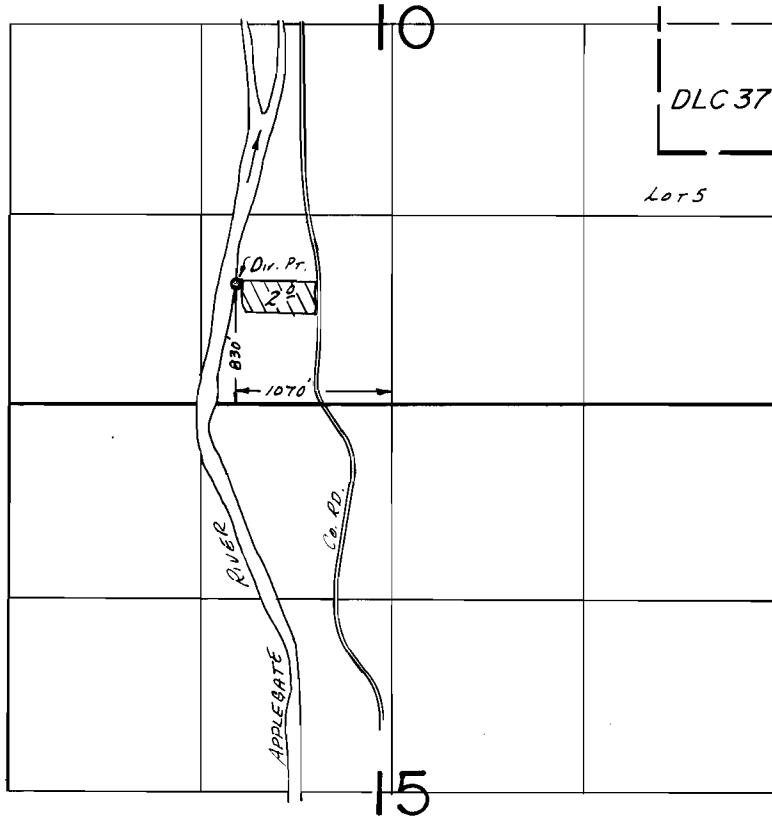

SCALE: 1" = 1320'

FINAL PROOF SURVEY
UNDER

Application No. 62186... Permit No. 46026.....
IN NAME OF

.....DAVE & JUDI HOWLETT.....

Surveyed July 3..... 19.85, by B.S. JAMES.....