


T.38S.,R.3W.,W.M.

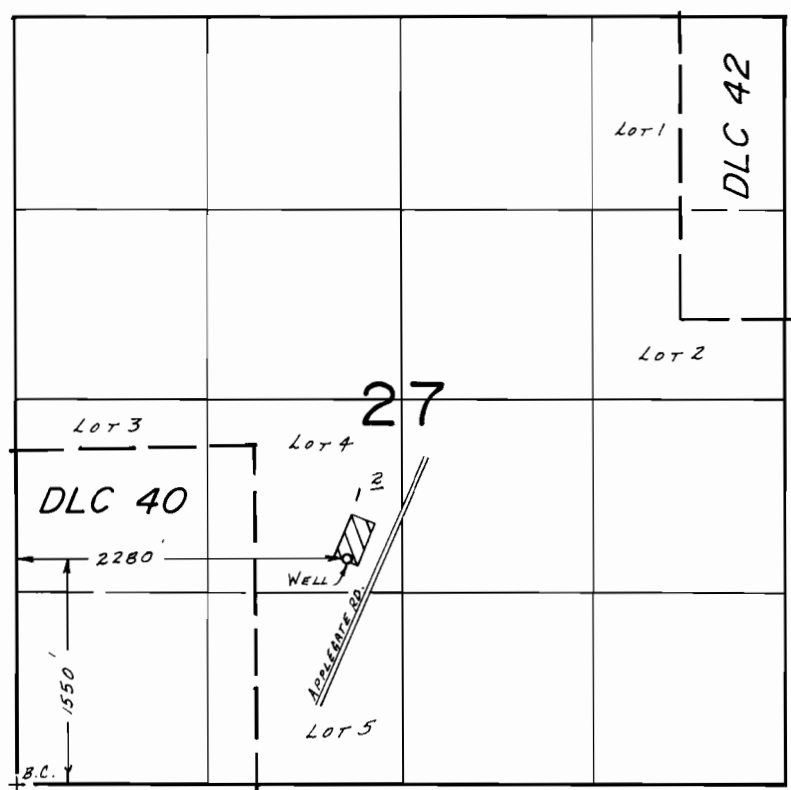

SCALE: 1" = 1320'

FINAL PROOF SURVEY UNDER

Application No. G-10623 Permit No. G-9780.....
IN NAME OF

.....ELVIN HAWORTH.....

Surveyed June 12.... 1985., by ..B.S. JAMES.....