


T. 39S., R. 3W., W.M.

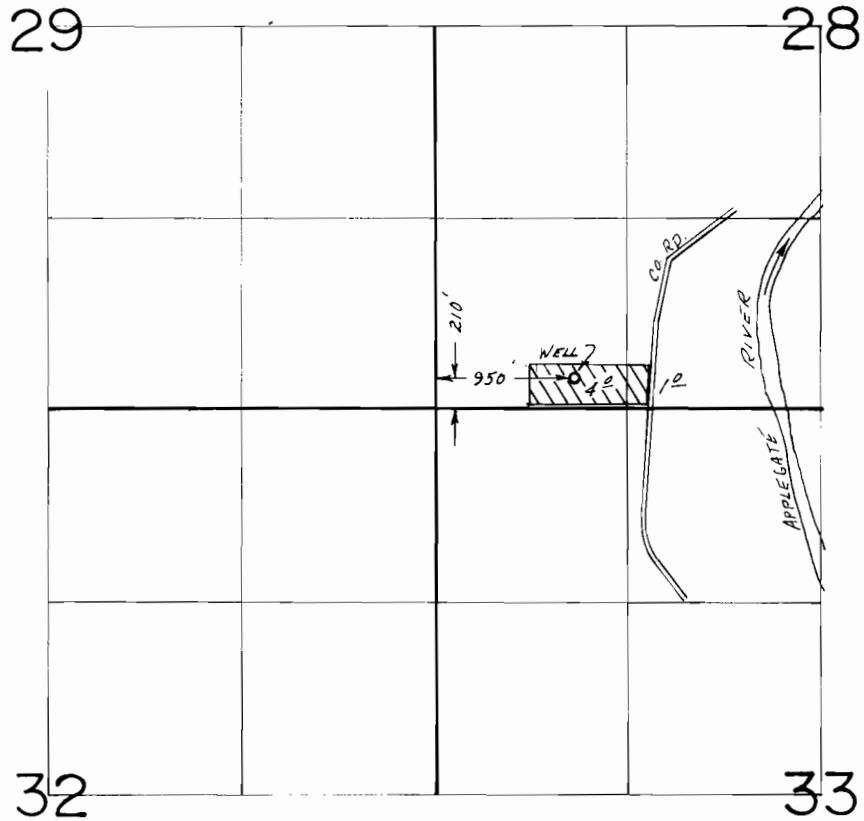

SCALE: 1" = 1320'

FINAL PROOF SURVEY UNDER

Application No. G-10814 Permit No. G-9907....
IN NAME OF

CHARLES C. OR MYRNA L. SPURGEON

Surveyed July 9..... 19.85, by B.S. JAMES.....