


T.30S., R.16E., W.M.

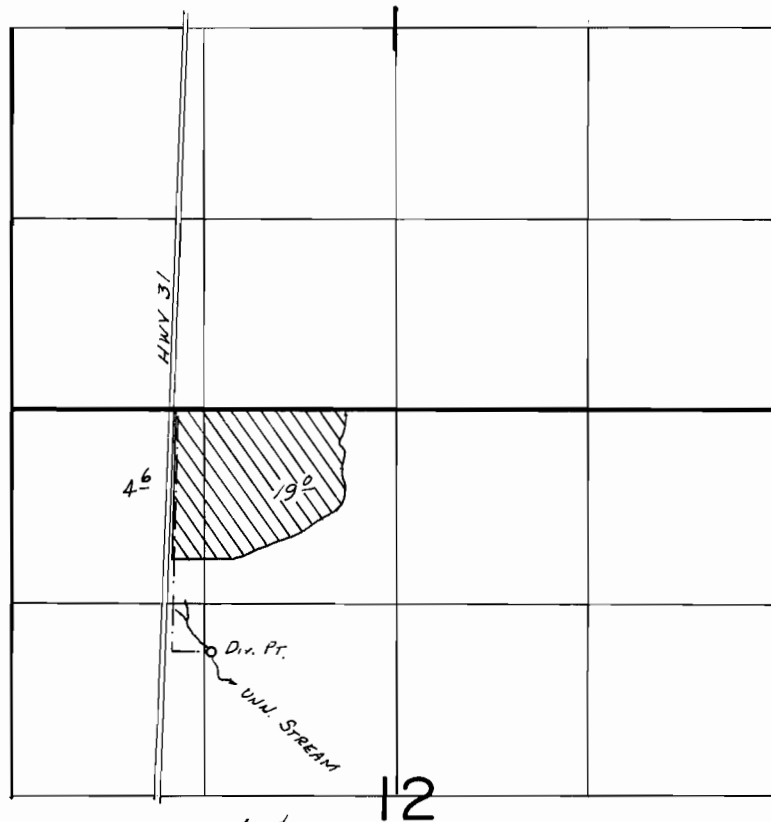

DIV. PT. LOC.: 1670'S & 1370'E. FROM NW COR. SEC. 12.

SCALE: 1"= 1320'

FINAL PROOF SURVEY

UNDER

Application No. 54958... Permit No. 41576.....
IN NAME OF

JEREMIAH P. O'LEARY.....

Surveyed Oct. 14..... 1985, by B.W. BISHOP.....