


T.26 S., R.15 E., W.M.

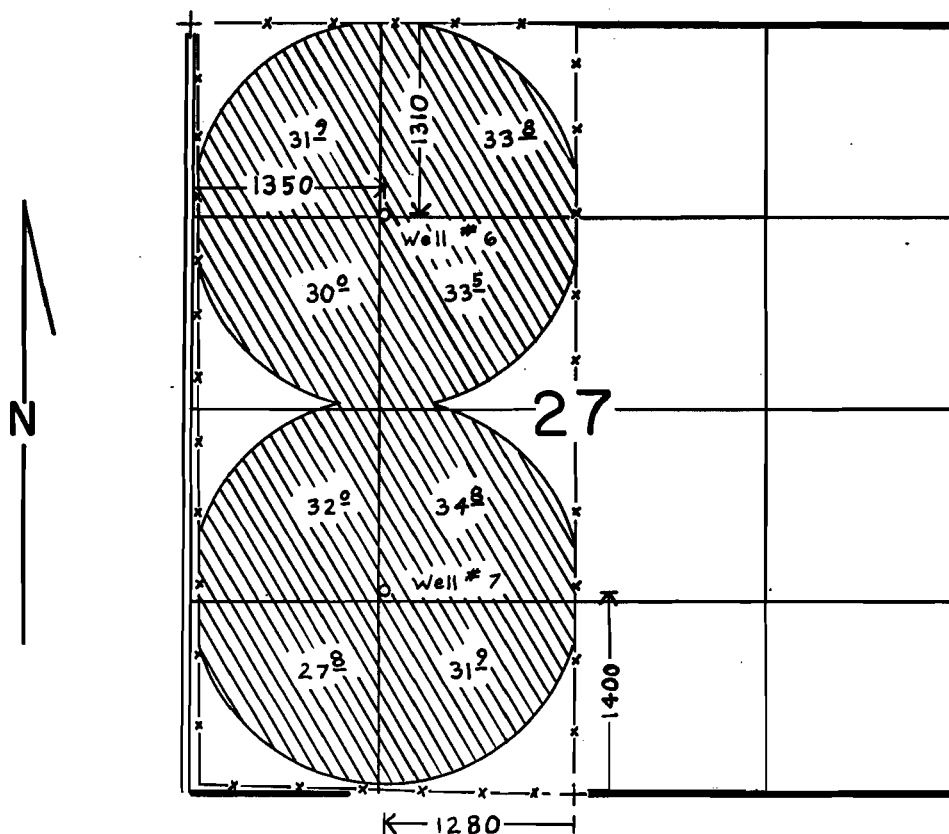

SCALE: 1"=1320'

FINAL PROOF SURVEY UNDER

Application No. G-10295 Permit No. G-9352.....
IN NAME OF

.....**JOHN & NORMA FLAMING**.....

Surveyed JUNE 19... 1985., by **LESLIE OLSON**.....