


T.16S.R.5W.W.M.

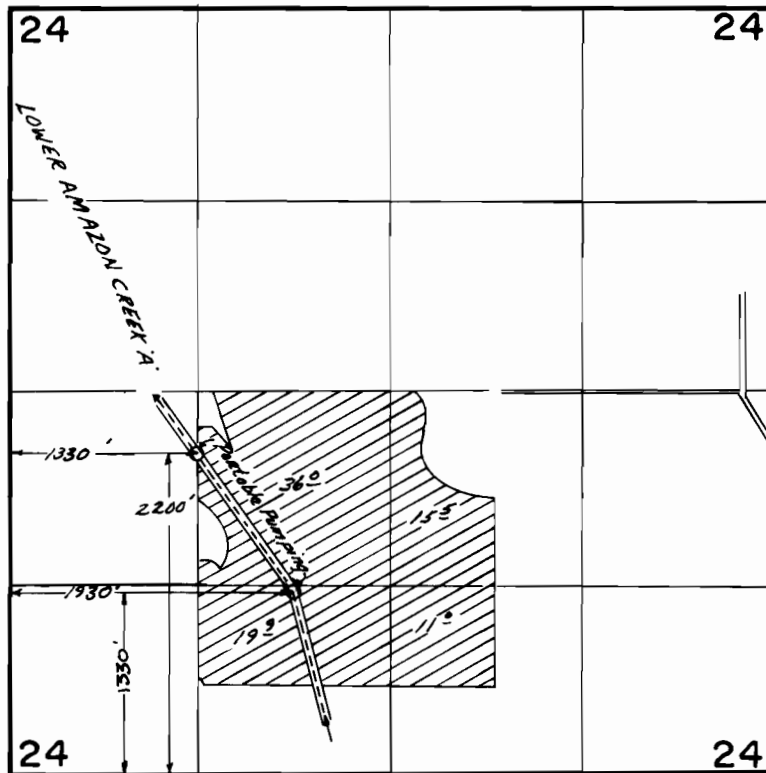

FINAL PROOF SURVEY
UNDER

Application No. 52934 Permit No. 39922....
IN NAME OF

.....THOMAS E. HUNTON.....

Surveyed May 18, 1979, by S.C. BROWN.....