


T.16S., R.5W., W.M.

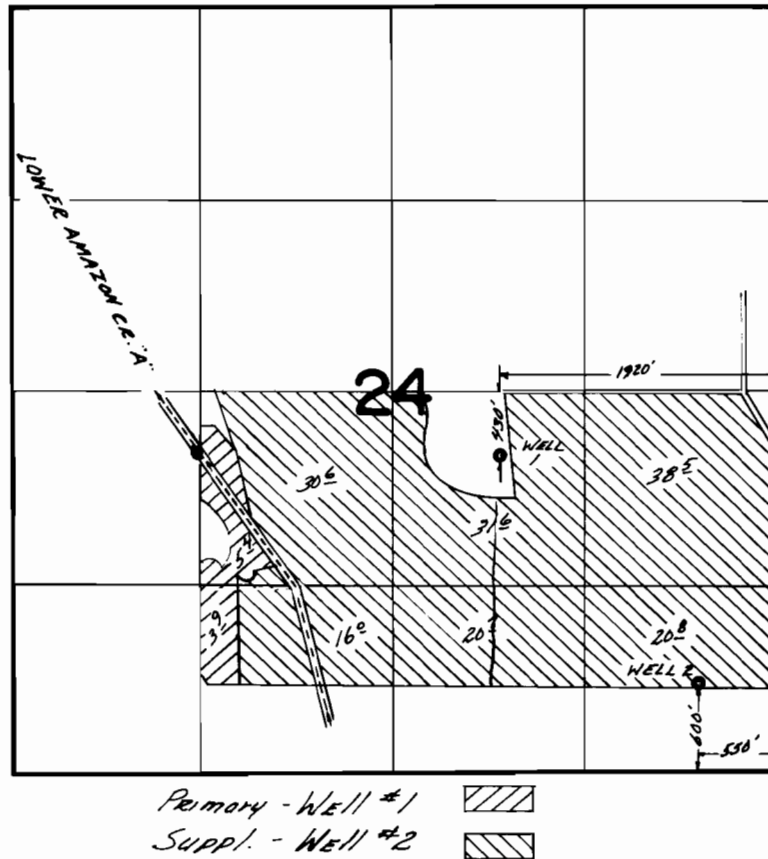

FINAL PROOF SURVEY
UNDER

Application No. G-6872 Permit No. G-6675...
IN NAME OF

.....THOMAS E. HUNTON.....

Surveyed May. 18... 1979., by S.C. BROWN.....