


T. 18 S., R. 2 W., W.M.

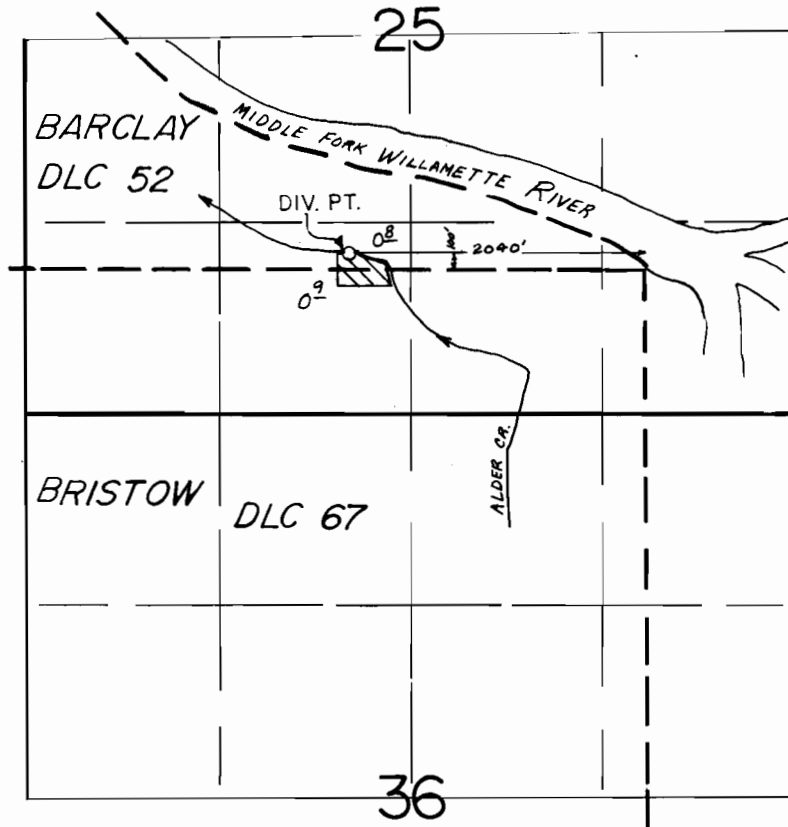

SCALE: 1" = 1320'

FINAL PROOF SURVEY
UNDER

Application No. 62819 Permit No. 46596
IN NAME OF

REAGAN E. AND CAROLE WELLS

Surveyed MAY 9, 1985, by P. R. PAGTER