


# T. 16S. R. 3W. W. M.

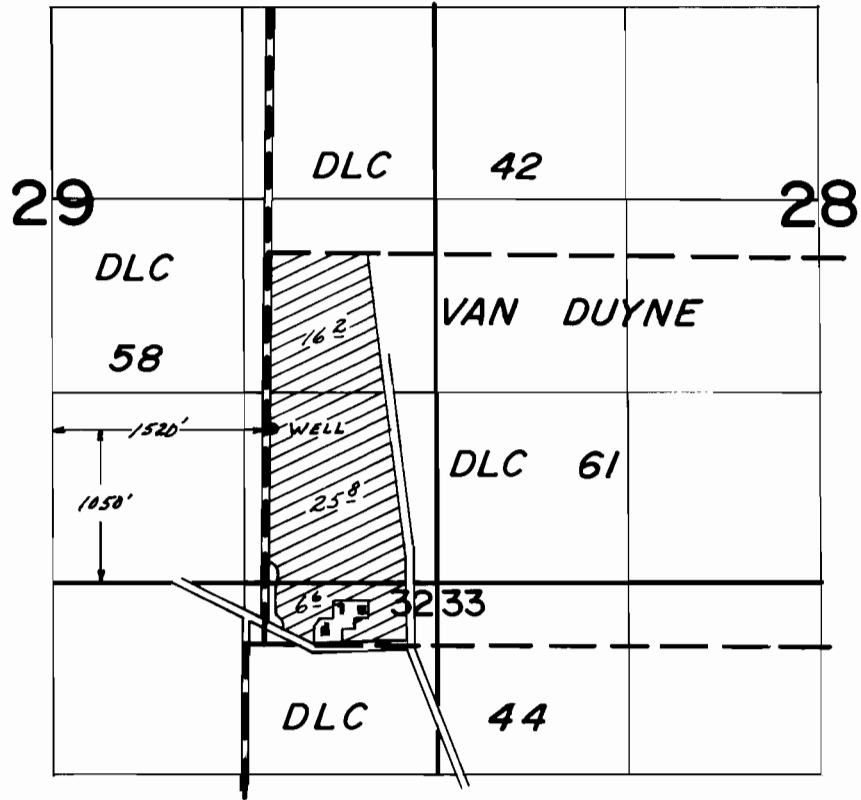

## FINAL PROOF SURVEY

UNDER

Application No. G-7.960 Permit No. G-7.397...  
IN NAME OF

.....Irwin C. Whitaker.....

Surveyed May..16.. 1979., by S.C.BROWN.....