


T.17 S., R.5 W., W.M.

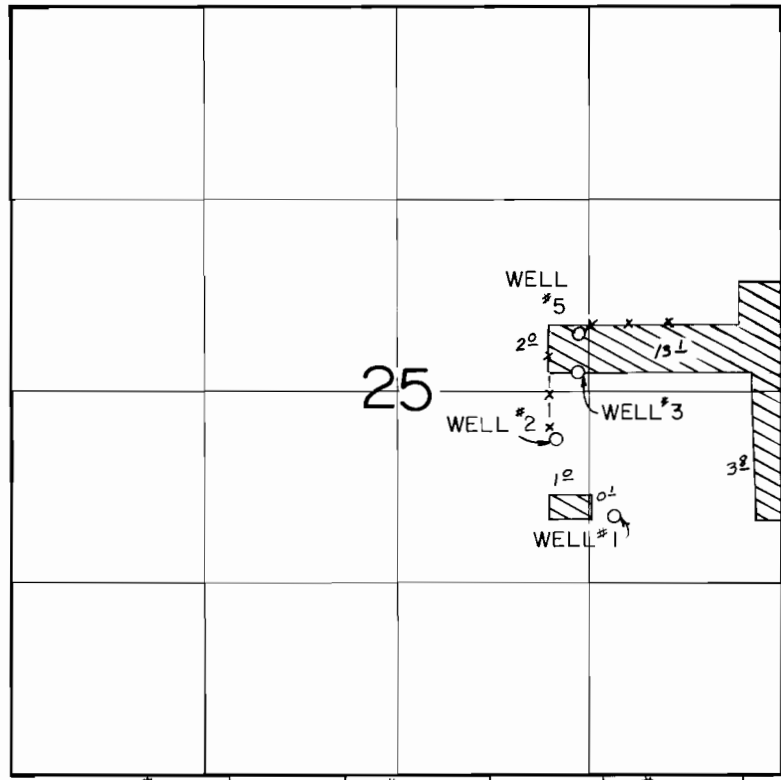

WELL LOC: #1-1760' N. & 1140' W., #2-2300' N. & 1540' W., #3-2760' N. & 1400' W., #5-3010' N. & 1400' W.

FINAL PROOF SURVEY
UNDER

Application No. G-10649 Permit No. G-10020
IN NAME OF

ARIE MACK MOORE AND EVANELL E. MOORE

Surveyed MAY 8, 1985, by P. R. PAGTER