
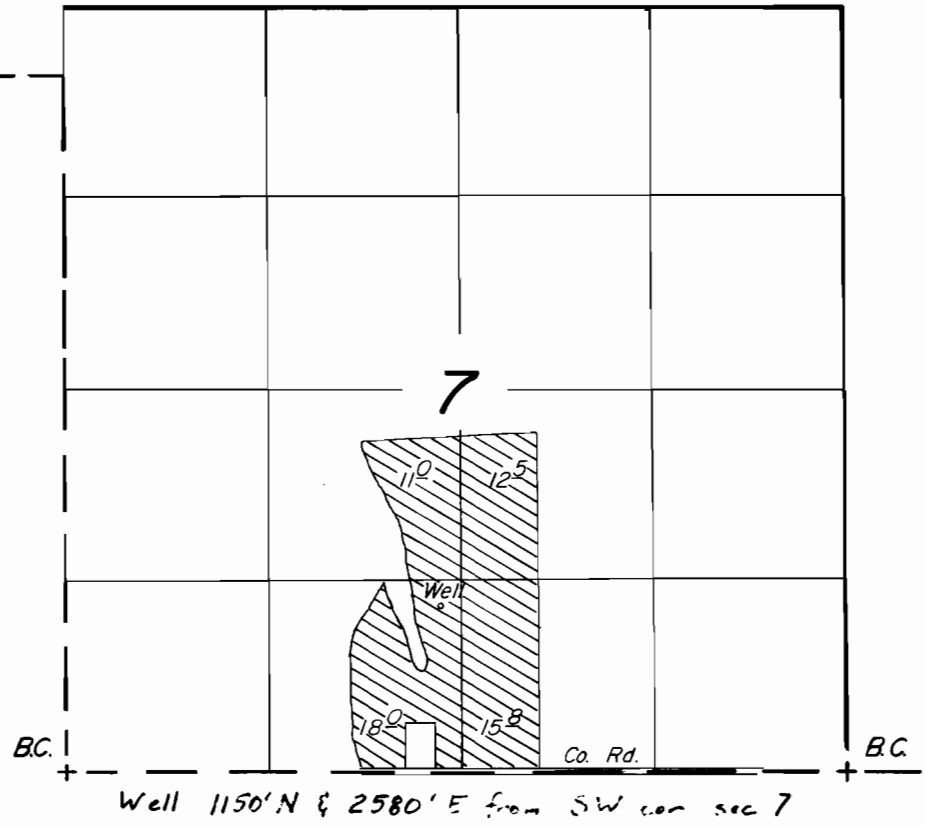


T. 15 S., R. 4 W., W.M.

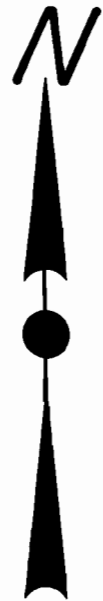

Scale: 1" = 1320'

FINAL PROOF SURVEY
UNDER

Application No. G-10924. Permit No. G-10057...
IN NAME OF

HOILAND BROTHERS

Surveyed May...6... 19.85., by .P. Pagter.....