


T. 12S., R. 2W., W.M.

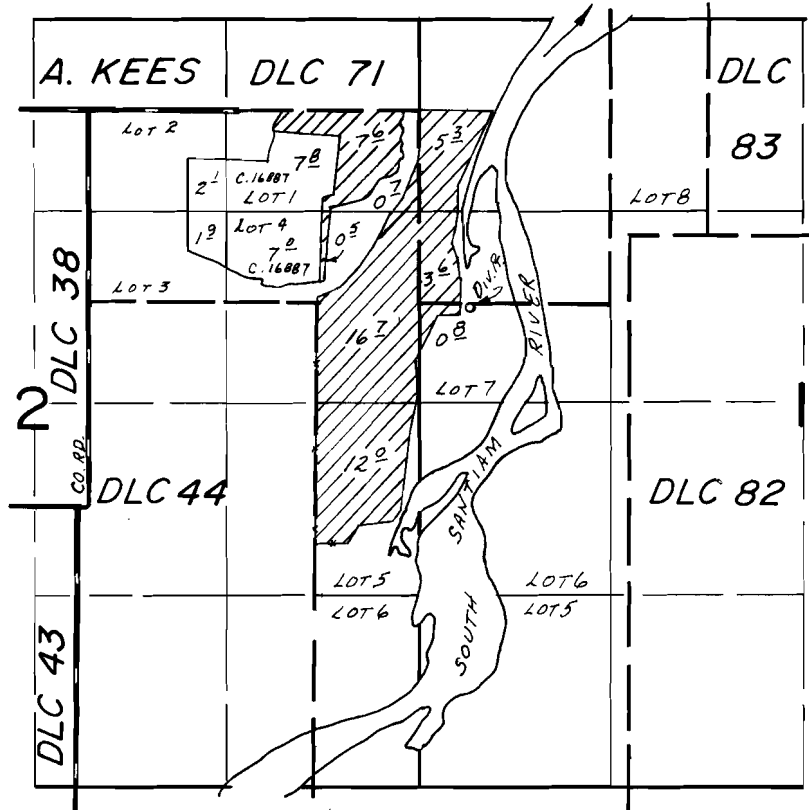

Div. Pt. Loc: 1980's. # 350'E. FROM THE NW COR. SEC. 1

**FINAL PROOF SURVEY**  
UNDER

Application No. 53348.. Permit No. 39579.....

IN NAME OF

.....CDR. B. W. DEACON (USN Ret).....

Surveyed .MAY. 26 1982., by L.M. TOLL.....