


# T.12&13S.R.IW.W.M.

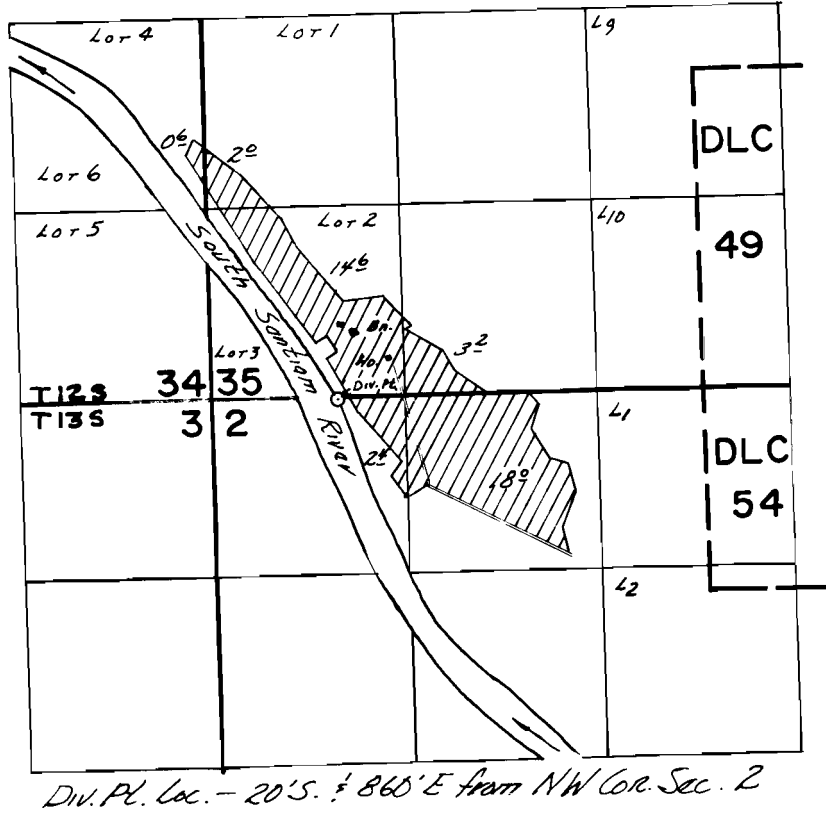

## FINAL PROOF SURVEY UNDER

Application No. **54398**. Permit No. **407.76**....  
IN NAME OF

.....**JEFF. FALEN**.....

Surveyed **May...3...** 1979., by **S.C.BROWN**.....