


T. 10S., R. 1W., W.M.

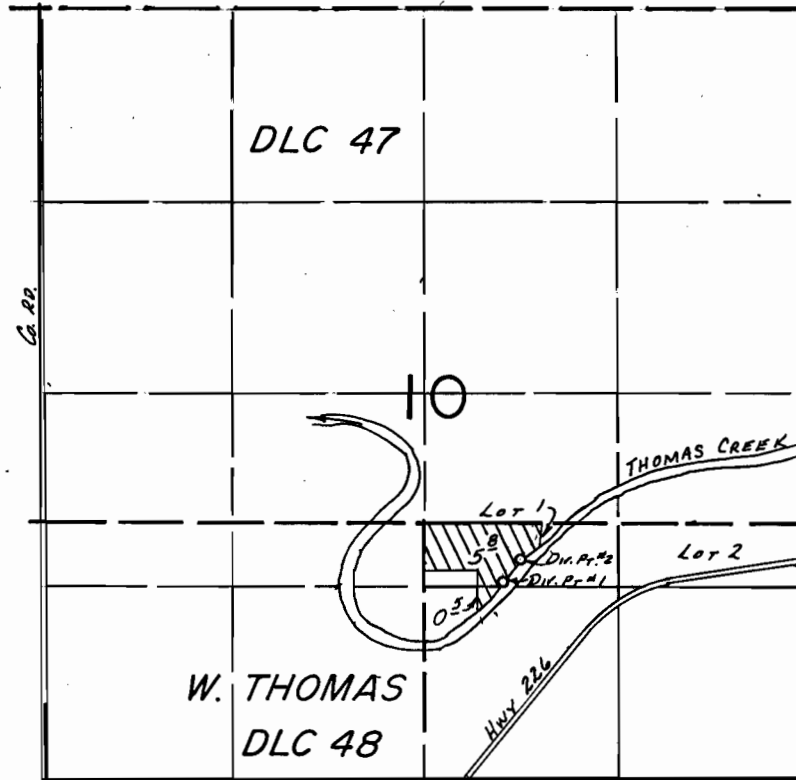

Div. Pts Loc.: #1-400'S. & 550'E.; #2-250'S. & 660'E.; BOTH FROM N.E. COR. W. THOMAS DLC 48.

SCALE: 1"=1320'

FINAL PROOF SURVEY
UNDER

Application No. 61320... Permit No. 45736.....
IN NAME OF

.....AUGUST H. RAUCH.....

Surveyed Sept. 3..... 1985, by T.M. WARREN.....
Sept. 22 1986 B.W. BISHOP

9/29/86
41043-278-141R
DFM-3LL-141
BWB