


T8S R4W WM

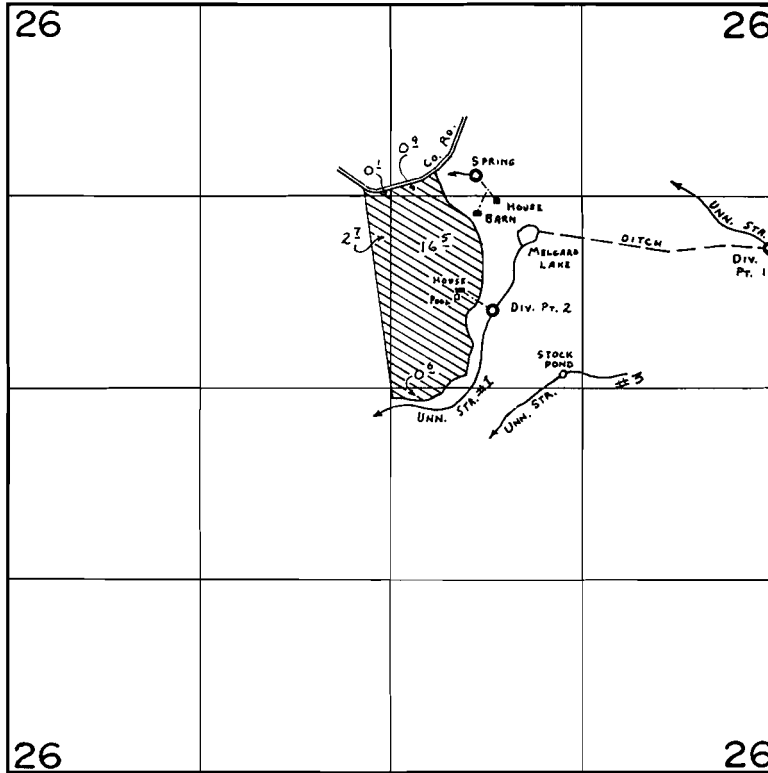

MELGARD LAKE LOC: 980' N. & 1740' W.
 STOCK POND LOC: 100' N. & 1450' W.
 SPRING LOC: 1450' N. & 2050' W.
 DIV. Pt. 1 LOC: 950' N. & 50' W.
 DIV. Pt. 2 (APP. 59745): 530' N. & 1930' W. } ALL FROM E. 1/4 COR. SEC. 26.

FINAL PROOF SURVEY UNDER

R-50663
 50664

R-6072
 37384

Application No. 59745... Permit No. 44892...

IN NAME OF

MARK A. MELGARD

Surveyed APR. 30. 19. 80., by C. L. HUGHES