


T9S R3W WM

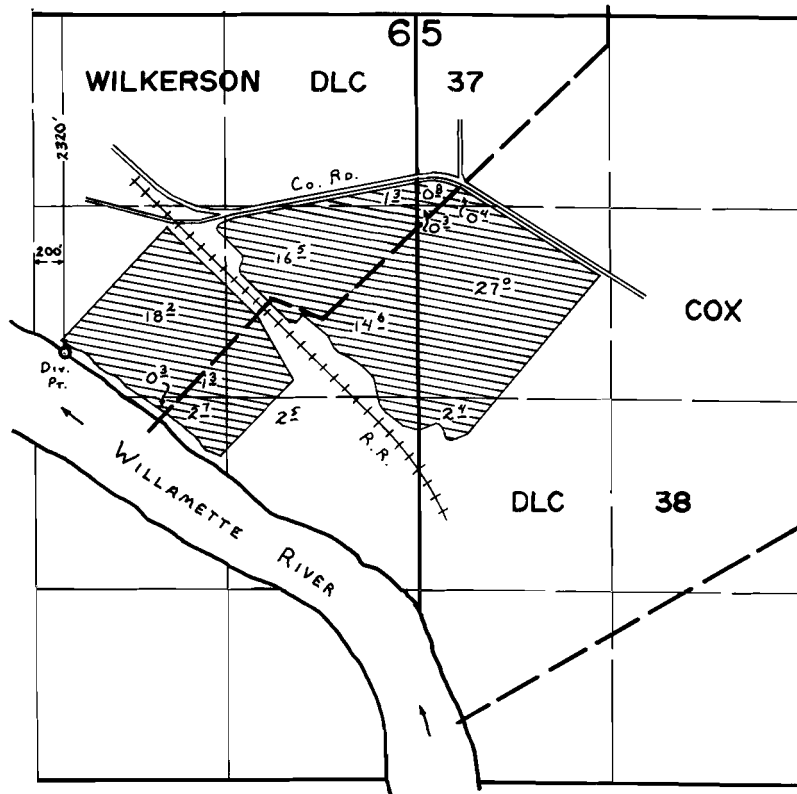

FINAL PROOF SURVEY UNDER

Application No. 55243 Permit No. 41621.....
IN NAME OF

ESTATE of DAVID HAMPTON.....

Surveyed Apr. 23 1980, by C. L. HUGHES.....