


T. 8S., R. 4W., W.M.

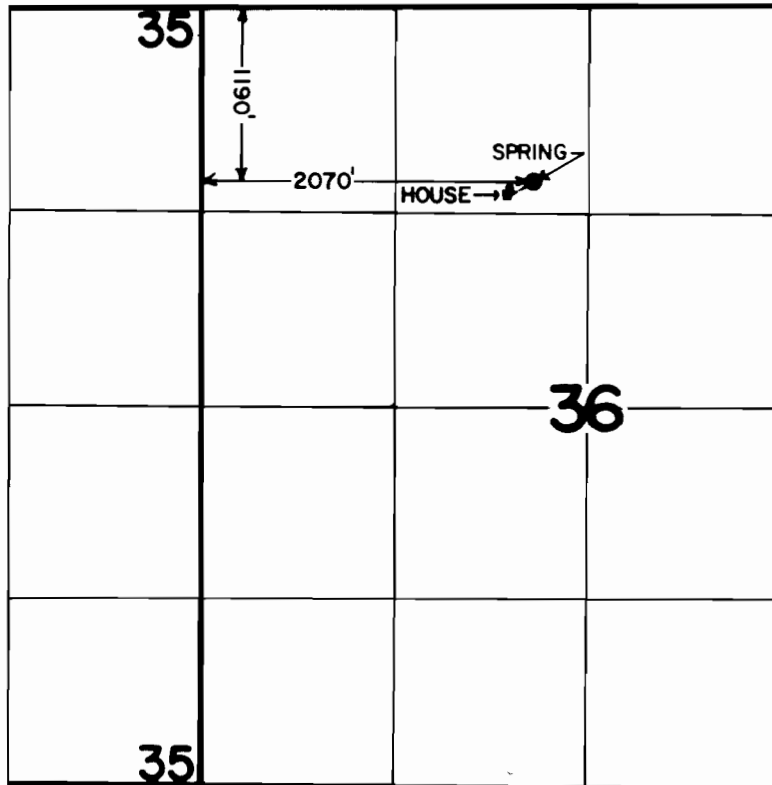

FINAL PROOF SURVEY
UNDER

Application No. 59203. Permit No. 44466....
IN NAME OF

GEORGE L. STENDER

Surveyed Apr. 22, 1980, by G.L. HUGHES....