


T. 5S., R. 2W., W.M.

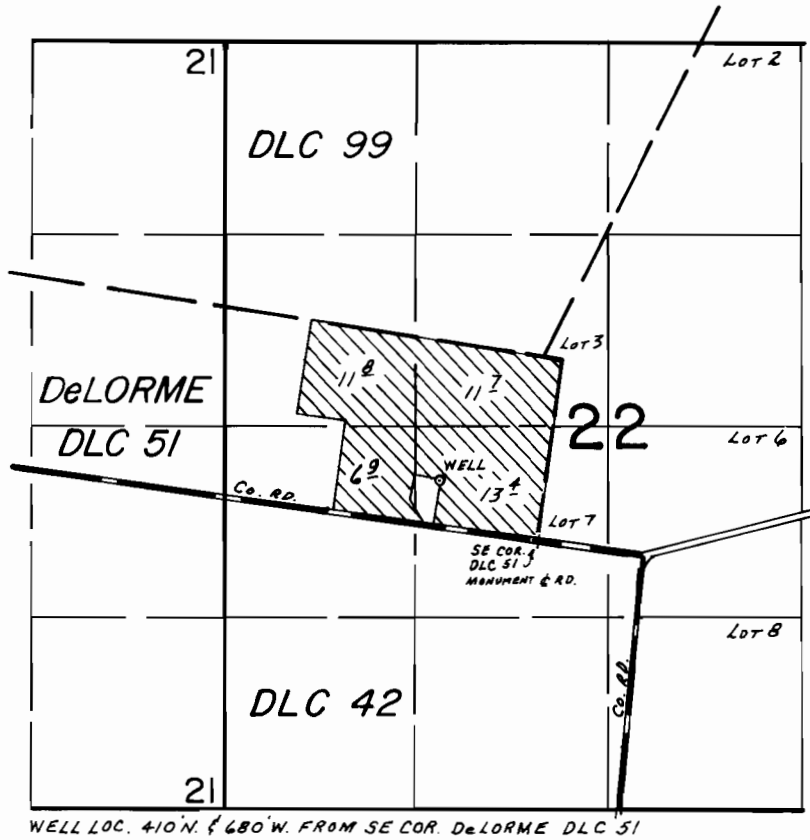

FINAL PROOF SURVEY UNDER

Application No. G-6768 Permit No. G-6287...
IN NAME OF

VIRGIL W. BINKLEY

Surveyed JULY 3... 1980, by C.L. HUGHES...