


T8S R2W WM

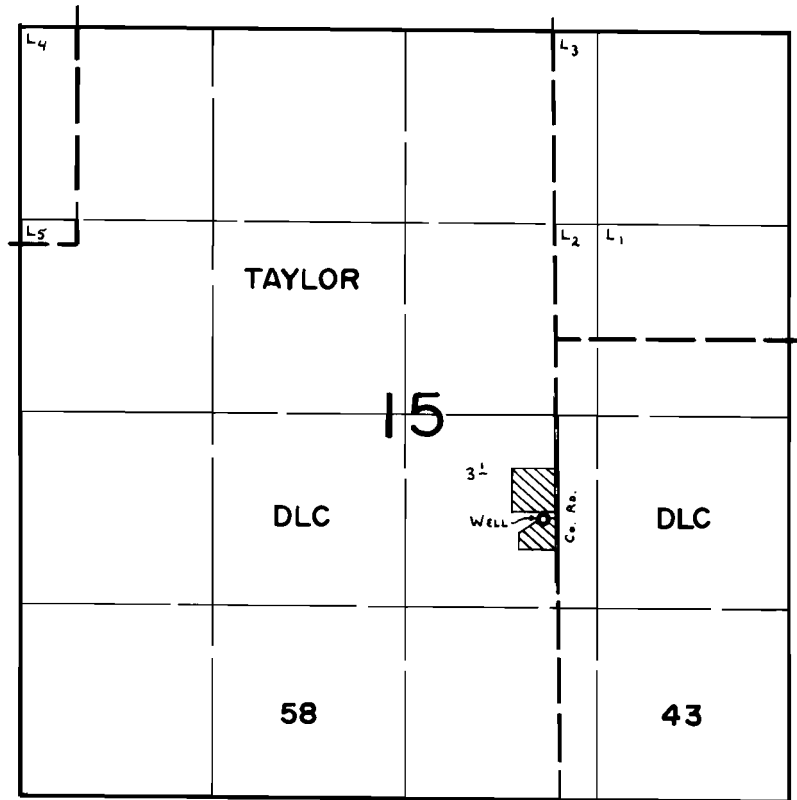

WELL Loc: 1230'S. & 90'W. fr. N.W. Cor. D.L.C. 43.

FINAL PROOF SURVEY
UNDER

Application No. ~~G-7469~~ Permit No. ~~G-6953~~
IN NAME OF

RAYMOND & MARTHA SATTERWHITE

Surveyed Apr. 25, 1980, by C. L. HUGHES