


T9S R4W WM

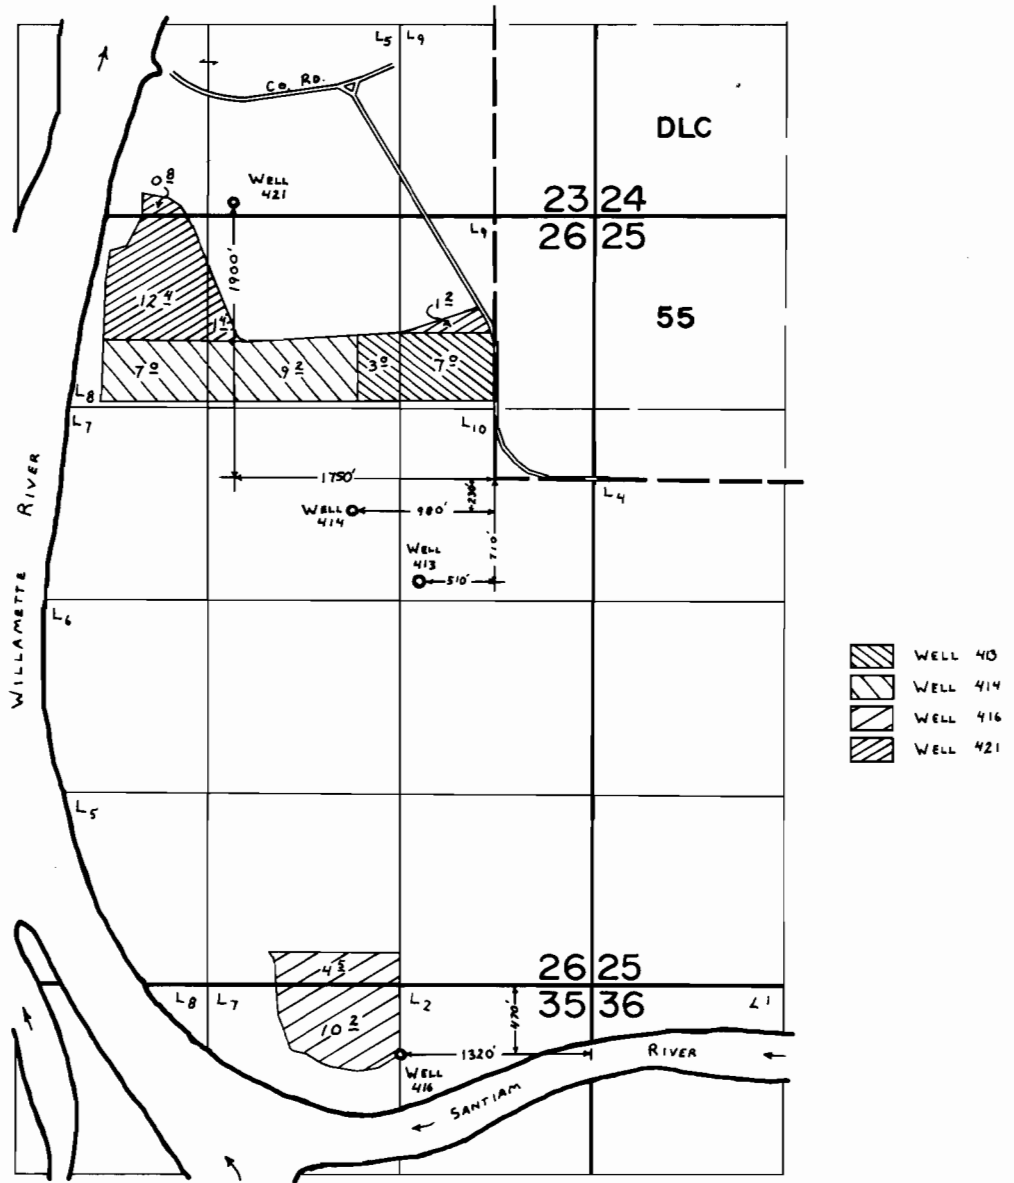

FINAL PROOF SURVEY UNDER

Application No. G-7534 Permit No. G-7006
IN NAME OF

MARI-LINN FARMS, INC

Surveyed APR 22 1980, by C. L. HUGHES