


T.7S. R.1W. W.M.

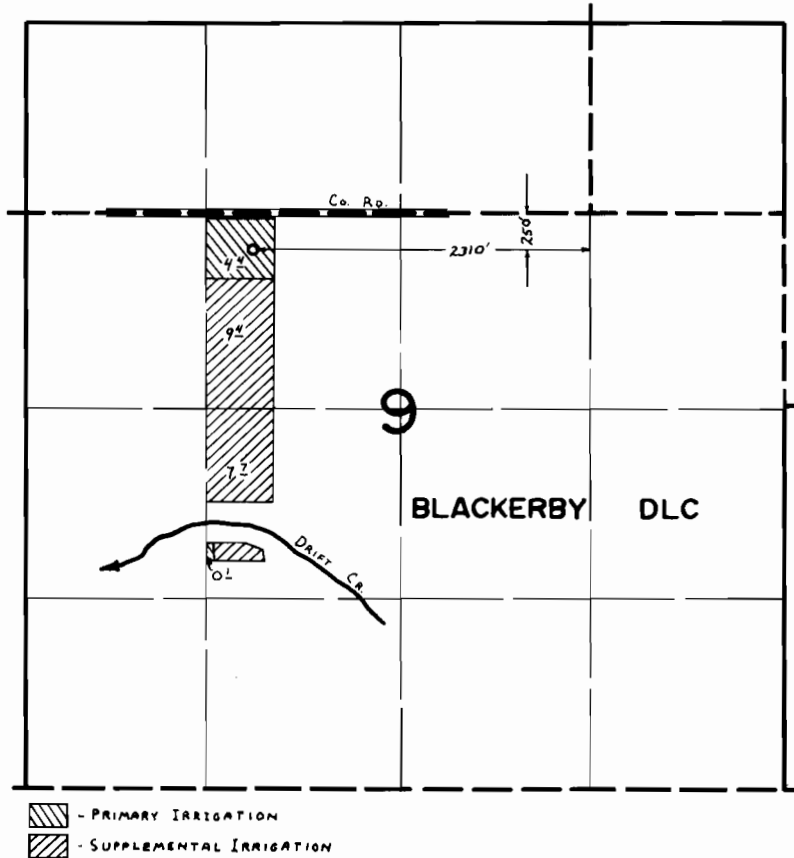

FINAL PROOF SURVEY UNDER

Application No. G-7634 Permit No. G-7071
IN NAME OF

WAYNE ZURBRUGG

Surveyed MAY 2 1980, by C.L. HUGHES