


# T7S RIW WM

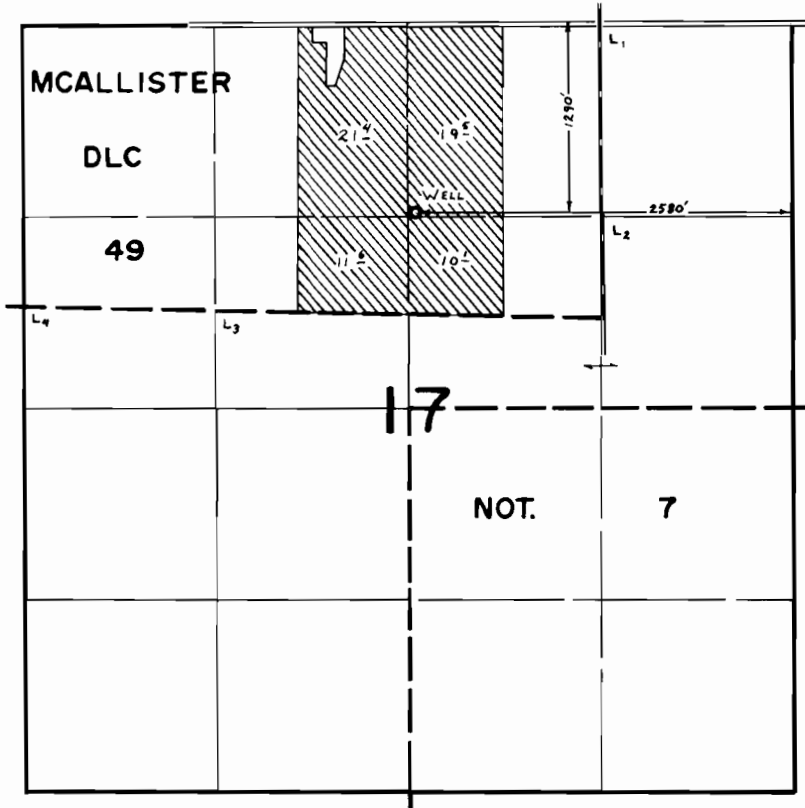

## FINAL PROOF SURVEY UNDER

Application No. G-7905 Permit No. G-7308  
IN NAME OF

CLIFFORD H. KUENZI

Surveyed JUNE 27 1980, by C. L. HUGHES