


T9S R2W WM

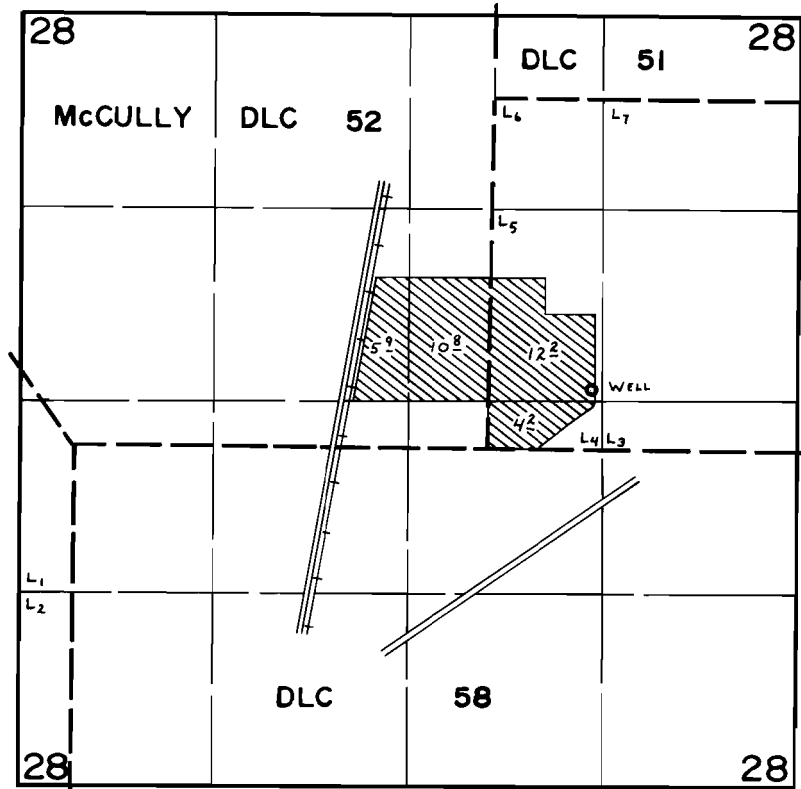

WELL Loc: 2000' S. & 680' E. fr. N.W. Cor. Lot 6.

FINAL PROOF SURVEY UNDER

Application No. G-7877 Permit No. G-7385
IN NAME OF

DORSEY B. GRAY

Surveyed Apr. 24 1980, by C. L. HUGHES