


T. 6S., R. 3W., W.M.

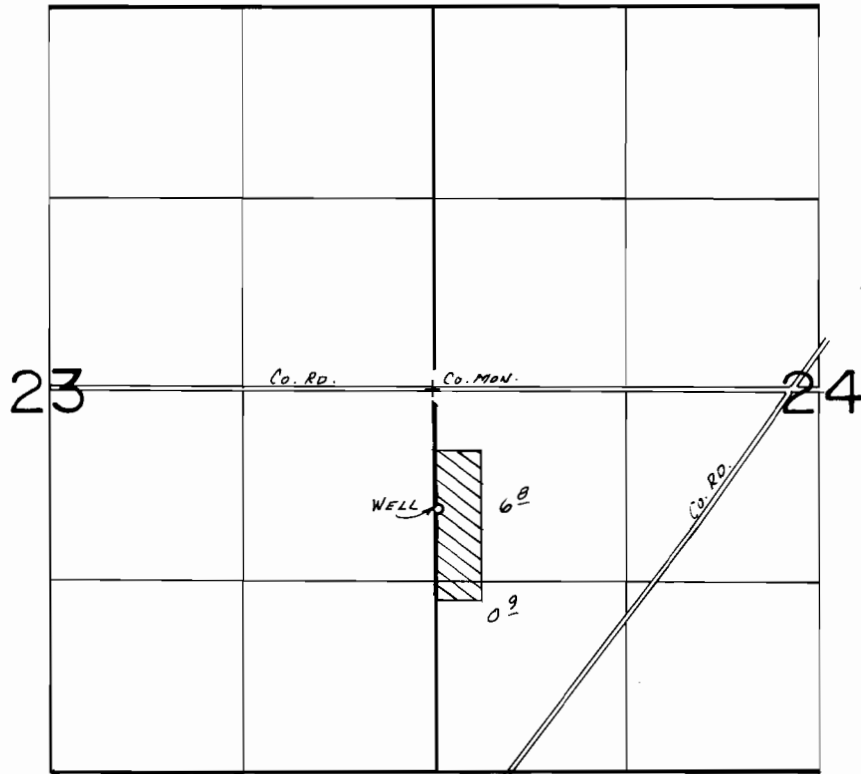

WELL LOC.: 830'S. & 40'E. FROM W. 1/4 COR. SEC. 24.

SCALE: 1" = 1320'

FINAL PROOF SURVEY
UNDER

Application No. G-8316.. Permit No. G-7717.....
IN NAME OF

.....WILHELM H. PRIES.....

Surveyed Mar. 28.. 19.86, by .T.M. WARREN....

4/11/86
BWB