


T7S RIW WM

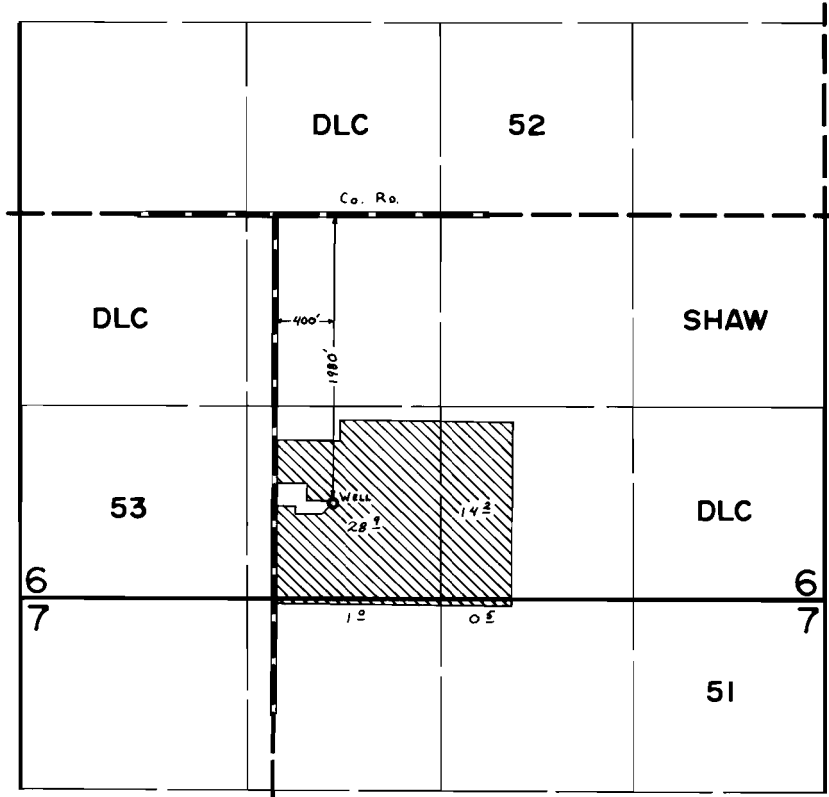

FINAL PROOF SURVEY UNDER

Application No. ~~G-8635~~ Permit No. ~~G-7949~~
IN NAME OF

.....ALFRED DETTWYLER.....

Surveyed MAY 2 1980, by C. L. HUGHES