


T7S R2W WM

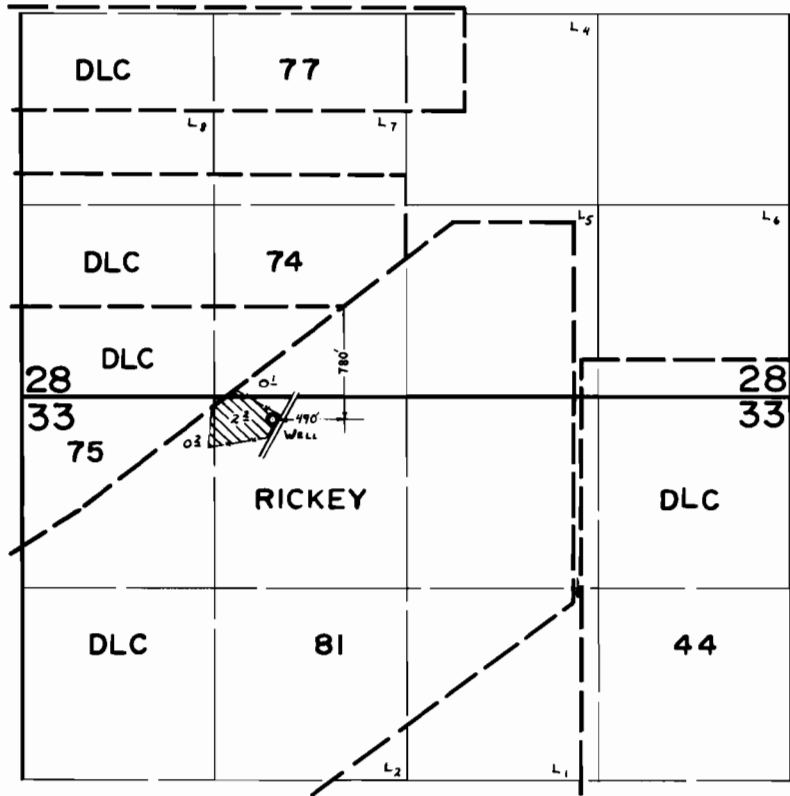

FINAL PROOF SURVEY UNDER

Application No. G-9320 Permit No. G-8714.....
IN NAME OF

RUSSELL & DOROTHY PEASE.....

.....ed May..... 1980., by C. L. HUNTER.....