


T. 2 S., R. 3 W. WM.

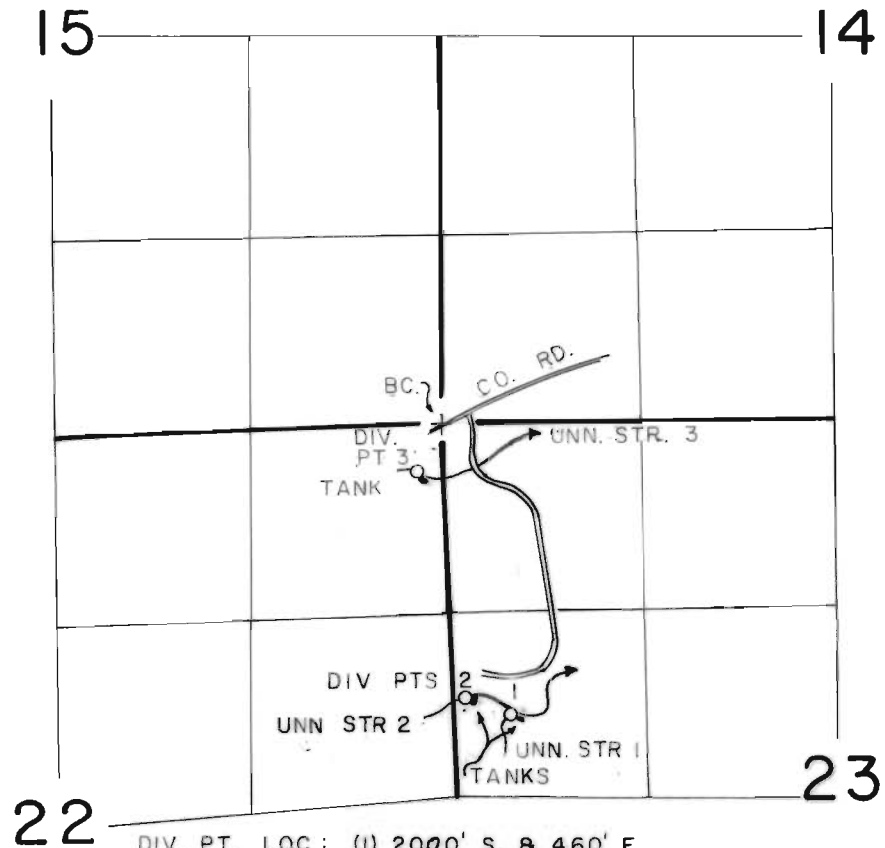

22 DIV. PT. LOC.: (1) 2000' S. & 460' E.
(2) 1870' S. & 160' E.
(3) 340' S. & 180' W.
FROM NW COR. SEC. 23

FINAL PROOF SURVEY
UNDER

Application No. 58949 Permit No. 45632
58950 Permit No. 45633
IN NAME OF

PAUL CASAVANT

Surveyed JUL 26 1984, by P. PAGTER