


T.26 S., R.11 W., W.M.

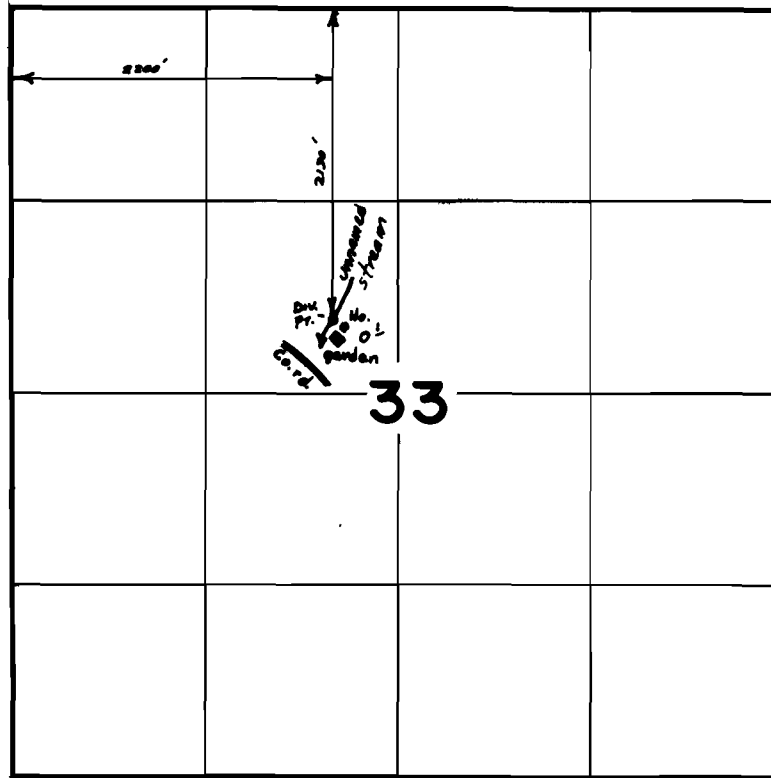

SCALE : 4" = 1 mile

FINAL PROOF SURVEY UNDER

Application No. 522.7.1... Permit No. 3.9335...
IN NAME OF

N. CLIFFORD & NEVA NELSON

Surveyed O.G.T. 9, 1979, by S. DONALDSON